

SURVEY & REMONUMENTATION

\$7.00
\$2.00

MAY 22 2000

LAND CORNER RECORDATION CERTIFICATE
Filing Requirement of Act 74, Mich. P.A. 1970
KENT COUNTY REMONUMENTATION

STATE OF MICHIGAN
COUNTY OF KENT
RECEIVED FOR RECORD
1999 DEC - 8 AM 10:00

REG. OF DEEDS
[Signature]

11515

Register of Deeds Stamp & File Number

For corners in	SECTION	Located in:	Nelson Township	Corner Code #
Kent (County)				
1. Public Land Survey	T 10N	R 10W		D-13
	T	R		
	T	R		
	T	R		
2. Property Controlling in Section	S	T	R	
	S	T	R	
3. Miscellaneous Property in Sec.	S	T	R	
	S	T	R	

4. Lot No. _____, Recorded Plat _____
5. Private Claims _____

I, Randy Kolehouse, in a field survey on March 15 19 99, do hereby certify that under requirements of P.A. 74 Michigan P.A. of 1970, the corner points mentioned in lines 1 and 2 above were in conformance with regulations and rules therefore as required in the current manual of survey instructions of the United States Department of the interior, Bureau of Land Management or by a decree of a Court of Law and/or that the corner points mentioned in lines 3, 4 and 5 above were in conformance with the rules of the Michigan Board of Land Surveyors or by a Decree of a Court of Law; established, re-established, monumented, re-monumented, recovered, found as expressed below:

NOTE: Not more than 4 corners, all in the same town and range, may be recorded on this certificate.

A. Description of original monument and accessories and/or subsequent restoration:

D-13	1837	G.L.O. Notes	Cathcart	Set Post
	1939	Witness Map	K.C. Surveyor	3/4" Iron in 1 1/2" Iron
	1982	L.C.R.C. #2687	Glen Hackbardt	1/2" Rod
	1982	L.C.R.C. #3095	Jonker Land Surveys	Fnd. 1/2" Iron / Set K.C. Monument
	1993	L.C.R.C. #6683	John Bueche	K.C. Monument

Note: This corner is not common with D-1, T9N, R10W.

This corner was originally approved by the Kent County Remonumentation Peer Group and monumented by Rob Jonker on 8/30/82 and was recorded per L.C.R.C. #3095.

B. Description of corner evidence found and/or method applied in restoring or reestablishing corner:

D-13 Monument had been removed. Set a temporary PK Nail on the C/L of 16 Mile Road (bit.) running East and West and 3' ± East of a tree row and fence line running North using existing witnesses from L.C.R.C.'s #2687, #3095, #6683 and the K.C. Surveyor's records.

L.C.R.C. #3095

L.C.R.C. #6683

Remon. tag on NW side p.pole S60°W 70.72'
Remon. tag on SE side 18" Hickory N60°E 60.11'
NE cor. house fnd. S40°W 168.5'
P.K. nail in face p.pole N25°E 177.3'
Capped Iron N 33'
On tree line to N
C/L E-W gravel S 2'


Nail & K.C. Remon. Tag I NW side PP S 60° W 70.72' (m. 70.61')
Nail & K.C. Remon. Tag in SE side 20" Hickory N 60° E 60.10' (m. 60.23')
NE cor. house fnd. S 40° W 168.31' (m. 168.47')
PK nail in face PP N 25° E 177.38' (m. 177.48')
Tree & fence line N, W 3'+/-, C/L E-W gravel S 2'+/-
K.C. Mon. (N 1/4 5, 9-10) East 80.34' (m. 80.48')

The selected location is accepted by me and is generally accepted by professional surveyors as the best available evidence of the position of the original corner.

C. Description of monument for corner and accessories established to perpetuate locating the position of the corner:

D-13 Reset a Standard Kent County Monument - Also Set a New Monument Box


- Nail & K.C. remon. tag on NW side P. pole S 60° W 70.61'
- Nail & K.C. remon. tag on SE side 26" Hickory N 60° E 60.23'
- NE cor. hse. fndn. S 40° W 168.47'
- PK in S face P. pole N 25° E 177.48'
- Nail & K.C. remon. tag on W side 10" Box Elder N 05° W 29.74'
- On C/L of bit. road running E-W
- Tree row and fence line running N, West 3' ±
- K.C. Mon. D-1, T9N, R10W, East 80.48'

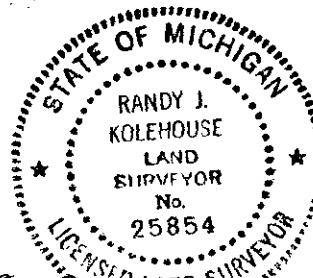

Signed by Randy J. Kolehouse Date 10-29-99

WILLIAMS & WORKS

Surveyor's Michigan License No. 25854

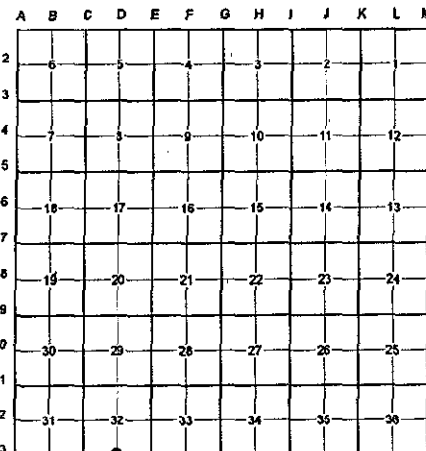

P.A. 345 1990 KENT COUNTY

PEER APPROVED 10/26/99
CHAIRMAN [Signature]