

LAND CORNER RECORDATION CERTIFICATE
Filing Requirement of Act 74, Mich. P.A. 1970

REC
 93 AUG 11 1993

For corners in
Kent
 (County)

Located In:

Corner Code H-6

- | | | | | | |
|------------------------------------|---|------------|---|------------|---|
| 1. Public Land Survey | T | <u>10N</u> | R | <u>10W</u> | |
| | T | _____ | R | _____ | |
| | T | _____ | R | _____ | |
| | T | _____ | R | _____ | |
| 2. Property Controlling in Section | S | _____ | T | _____ | R |
| | S | _____ | T | _____ | R |
| 3. Miscellaneous Property in Sec. | S | _____ | T | _____ | R |
| | S | _____ | T | _____ | R |

6816

Register of Deeds Stamp & File Number

4. Lot No. _____ Recorded Plat _____
 5. Private Claims _____

	A	B	C	D	E	F	G	H	I	J	K	L	M
2	6		5		4					2			1
3													
4	7		8		9								12
5													
6	18		17		16								13
7													
8	19		20		21			22		23			24
9													
10	30		29		28			27		26			25
11													
12	31		32		33			34		35			36
13													

I, Wallace E. Glaza, in a field survey on August 4, 1993
do hereby certify that under requirements of P.A. 74, Michigan P.A. of 1970, the corner points mentioned in lines 1 and 2 above were in conformance with regulations and rules therefore as required in the current manual of survey instructions of the United States Department of the Interior, Bureau of Land Management or by a decree of a Court of Law and/or that the corner points mentioned in lines 3, 4 and 5 above were in conformance with the rules of the Michigan Board of Land Surveyors or by a Decree of a Court of Law, established, re-established, monumented, re-monumented, recovered, found as expressed below.


NOTE: Not more than 4 corners, all in the same town and range, may be recorded on this certificate.

A. Description of original monument and accessories and/or subsequent restoration
 No previous history.

B. Description of corner evidence found and/or method applied in restoring or reestablishing corner:
 H-6 (center of Section 15, T10N, R10W, Nelson Township, Kent County, Michigan)
 Found 1½" pipe with cap. Verified pipe to be 1.33' North and 0.99' East of intersection of ¼ lines. Accepted pipe as center.
 Replaced 1½" pipe and cap with standard 4" x 30" Harrison Monument.
 South ¼ corner to center - 2643.16'
 West ¼ corner to center - 2631.34'
 North ¼ corner to center - 2653.34'
 East ¼ corner to center - 2664.42'

C. Description of monument for corner and accessories established to perpetuate locating the position of the corner:
 H-6 (standard 4" x 30" Harrison Monument)

- | | | |
|--|-------|---------|
| 1) Nail and tag in SW side 14" Triple Cherry | N40°E | 40.98' |
| 2) Nail and tag in SW side 10" Sassafras | S30°E | 34.70' |
| 3) Nail and tag in SE side 12" Cherry | S30°W | 81.48' |
| 4) Nail and tag in South side 12" Cherry | S90°W | 34.11' |
| 5) SE corner house foundation (No. 16015) | N50°W | 109.31' |
| 6) On centerline North/South road | | |

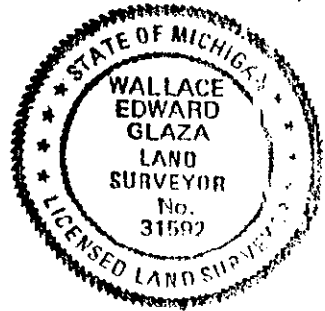

Signed by Wallace E. Glaza Date 8-9-93
 Surveyor's Michigan License No. 31592