

JAN 24 1996 KENT COUNTY REMONUMENTATION
COMMISSION
LAND CORNER RECORDATION CERTIFICATE
Filing Requirement of Act 74, Mich. P.A. 1970

\$7.00
\$2.00

| For corners in KENT COUNTY (County) | Located In: | Corner Code # |
|---|-------------------------|---------------|
| 1. Public Land Survey | T 10N R 10W | I-2 |
| | T _____ R _____ | _____ |
| | T _____ R _____ | _____ |
| | T _____ R _____ | _____ |
| 2. Property Controlling in Section | S _____ T _____ R _____ | _____ |
| | S _____ T _____ R _____ | _____ |
| 3. Miscellaneous Property in Section | S _____ T _____ R _____ | _____ |
| | S _____ T _____ R _____ | _____ |


STATE OF MICHIGAN
COUNTY OF KENT
RECEIVED FOR RECORD

95 SEP 14 PM 12:36

REG. OF DEEDS
W. J. ...
8714

Register of Deeds Stamp & File Number

4. Lot No. _____, Recorded Plat _____
5. Private Claims _____

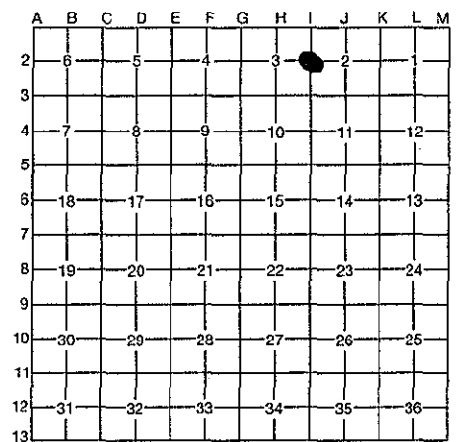

I, Kirk Breitels, in a field survey on July 12, 1995,
do hereby certify that under requirements of P.A. 74, Michigan P.A. of 1970, the corner points mentioned
in lines 1 and 2 above were in conformance with regulations and rules therefore as required in the current
manual of survey instructions of the United States Department of the Interior, Bureau of Land
Management or by a decree of a Court of Law and/or that the corner points mentioned in lines 3, 4 and
5 above were in conformance with the rules of the Michigan Board of Professional Surveyors or by a
Decree of a Court of Law; established, re-established, monumented, re-monumented, recovered, found
as expressed below:

NOTE: Not more than 4 corners, all in the same town and range, may be recorded on this certificate.

A. Description of original monument and accessories and/or subsequent restoration:

| | | | | |
|-----|------|------------------------|------|--------------------------------|
| I-2 | 1837 | GLO Cathcart Set Post | 1913 | Williams & Works Stone |
| | 1900 | Williams & Works Stone | | 12" Maple N 41.3' |
| | 1908 | Williams & Works Stone | | Fence Post NE 13.4' |
| | | Tel. Pole SE 29.5' | 1962 | Kent Co. Rd. Comm. 1 1/2" Iron |
| | | 8" Maple N 13.5' | | MBT Pole NNE 62.27' |
| | | On C/L new road N-S | | MBT Pole SSE 110.38' |
| | | C/L road E. | | 12" Elm SE 80.07' |

B. Description of corner evidence found and/or method applied in restoring or reestablishing corner:

I-2 Found 1" Iron Pipe over 1 1/2" Iron Pipe (30" below road) in C/L Asph Rd. N-S and on C/L 2 track trail to E. No Witnesses from any source remain.


| | |
|---|--|
| Meas. S. to SW cor. Sec. 2 (KCM) 2650.82' | Meas. N. to NW Sec. 2 (C. Mon.) 3087.13' |
| 1962 Kent Co. Rd. Com. = 2651.50' | 1913 Williams & Works = 3087.0' |
| 1913 Williams & Works = 2653' | Meas. N. to 1/8 cor. (Mon. Box) 1327.86' |
| | 1962 Kent Co. Rd. Com. = 1327.50' |
| Deflection Angle at I-2 = 00°07'10" | 1900 Williams & Works = 1327.7' |
| 1962 Kent Co. Rd. Com. = 00°07' | |

The 1" Iron Pipe over the 1 1/2" Iron Pipe is accepted by me and is generally accepted by professional surveyors as the best available evidence of the position of the original corner.

C. Description of monument for corner and accessories established to perpetuate locating the position of the corner:

- I-2 Set Standard Kent Co. Monument in place of 1" Iron Pipe over the 1 1/2" Iron Pipe.
- Set Nail & KC Remon. tag SE side P. Pole N55°E 81.05'
- Set Nail & KC Remon. tag SW side 12" Poplar S60°E 51.30'
- Set Nail & KC Remon. tag E. side P. Pole N10°W 221.27'
- Set Nail & KC Remon. tag NE side P. Pole N50°W 243.05'
- Set Nail & KC Remon. tag SE side P. Pole S65°W 214.48'

P.A. 345 1990 KENT COUNTY.
PEER APPROVED 8/24/95
CHAIRMAN [Signature]

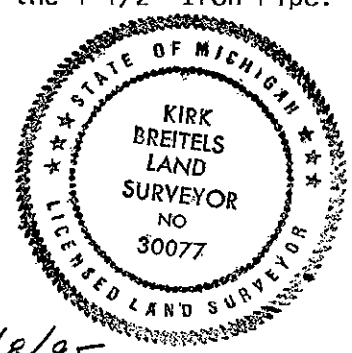

Signed by Kirk Breitels Date 9/8/95
30077
Surveyor's Michigan License No. _____