

MAY 22 2000

\$7.00
\$2.00

SECTION

LAND CORNER RECORDATION CERTIFICATE
Filing Requirement of Act 74, Mich. P.A. 1970
KENT COUNTY REMONUMENTATION

For corners in

| Kent (County) | Located in: | Nelson Township | Corner Code # |
|---------------------------------------|-------------|--------------------|---------------|
| 1. Public Land Survey | T 10N | R 10W | K-13 |
| | T | R | |
| | T | R | |
| | T | R | |
| 2. Property Controlling in Section | S | T | R |
| | S | T | R |
| 3. Miscellaneous Property in Sec. | S | T | R |
| | S | T | R |

STATE OF MICHIGAN
COUNTY OF KENT
RECEIVED FOR RECORD

1999 DEC - 8 AM 10: 01

REG. OF DEEDS

11522

Register of Deeds Stamp & File Number


4. Lot No. _____, Recorded Plat _____
5. Private Claims _____

I, Randy Kolehouse, in a field survey on February 10 19 99, do hereby certify that under requirements of P.A. 74 Michigan P.A. of 1970, the corner points mentioned in lines 1 and 2 above were in conformance with regulations and rules therefore as required in the current manual of survey instructions of the United States Department of the interior, Bureau of Land Management or by a decree of a Court of Law and/or that the corner points mentioned in lines 3, 4 and 5 above were in conformance with the rules of the Michigan Board of Land Surveyors or by a Decree of a Court of Law; established, re-established, monumented, re-monumented, recovered, found as expressed below:

NOTE: Not more than 4 corners, all in the same town and range, may be recorded on this certificate.

A. Description of original monument and accessories and/or subsequent restoration:

| K-13 | 1837 | G.L.O. Notes | Cathcart | Set Post |
|------|------|----------------|------------------|--|
| | N/A | Witness Map | K.C. Surveyor | Iron |
| | 1972 | L.C.R.C. #118 | M.M. Chambers | Iron |
| | 1972 | L.C.R.C. #133 | M.M. Chambers | Iron |
| | 1980 | L.C.R.C. #1749 | Williams & Works | Fnd. "T" Iron & Stones / Set K.C. Monument |
| | 1988 | L.C.R.C. #4775 | John Bueche | K.C. Monument |

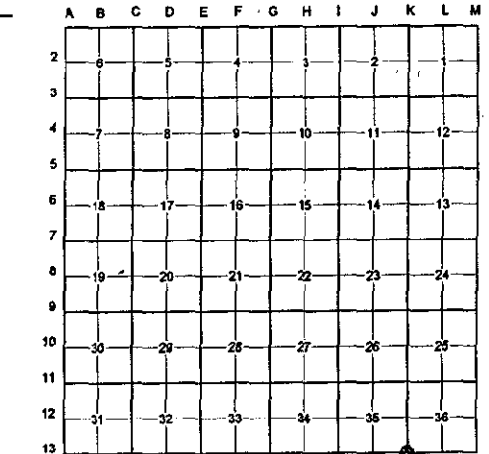

P.A. 345 1990 KENT COUNTY
PEER APPROVED 10/28/99
CHAIRMAN Randy Kolehouse

Note: This corner is not common with K-1, T9N, R10W.

This corner was originally approved by the Kent County Remonumentation Peer Group and monumented by Williams & Works on 12/18/80 and was recorded per L.C.R.C. #1749.

B. Description of corner evidence found and/or method applied in restoring or reestablishing corner:

K-13 Found a Standard Kent County Monument 4' ± East of the C/L intersection of Tisdell Avenue (gravel) running North and 16 Mile Road (gravel) running East and West per L.C.R.C.'s #1749 and #4775 as set by Williams & Works in place of a "T" iron and stones they found which checked L.C.R.C.'s #133, #118 and the K.C. Surveyor's records.

L.C.R.C. #1749

L.C.R.C. #4775

| | |
|---|---|
| K.C. Remon. Tag & Nail in W Side 24" Oak S 30°E 26.07' | Nail in W sde 28" Oak S 30 E 26.07' (m. 26.15') |
| K.C. Remon. Tag & Nail in S Side 6" Tri-Cherry S 80°E 124.79' | K.C. Remon tag & nail in S sde Quad 6" Cherry S 80 E 124.77' (m. 124.94') |
| K.C. Remon. Tag & Nail in S Side 10" Oak N 85°E 201.3' | K.C. Remon tag & nail in S sde 10" Oak N 85 E 201.73' (m. 201.75') |
| K.C. Remon. Tag & Nail in S Side T&P Pole N 30°E 92.86' | K.C. Remon tag & nail in S sde T & P Pole N 30 E 92.86' (m. 92.81') |
| K.C. Remon. Tag & Nail in W Side Tri-Oak N 25°E 109.81' | K.C. Remon tag & nail in W sde Tri-Oak N 25 E 109.81' (m. 109.89') |
| | On C/L gravel rd E & W |
| | C/L gravel rd N is W 4' N/L |
| | 1' below grade M/L |

The selected location is accepted by me and is generally accepted by professional surveyors as the best available evidence of the position of the original corner.

C. Description of monument for corner and accessories established to perpetuate locating the position of the corner:

K-13 Standard Kent County Monument

| | |
|--|---|
| Nail & K.C. remon. tag on W side 28" Oak S 30° E 26.15' | C/L of gravel road running N, West 4' ± |
| Nail & K.C. remon. tag on S side quad. 6" Cherry S 80° E 124.94' | On C/L of gravel road running E-W |
| Nail & K.C. remon. tag on S side 10" Oak N 85° E 201.75' | K.C. Mon., K-1, T9N, R10W, East 238.48' |
| Nail & K.C. remon. tag on S side T. & P. pole N 30° E 92.81' | |
| Nail & K.C. remon. tag on W side triple Oak N 25° E 109.89' | |

Signed by Randy J. Kolehouse Date 10-29-99
WILLIAMS & WORKS
Surveyor's Michigan License No. 25854

