

\$7.00
\$2.00

MAY 22 2000

SECTION

LAND CORNER RECORDATION CERTIFICATE
Filing Requirement of Act 74, Mich. P.A. 1970
KENT COUNTY REMONUMENTATION

For corners in

| Kent (County) | Located in: | Nelson Township | Corner Code # |
|---------------------------------------|--------------|--------------------|---------------|
| 1. Public Land Survey | T <u>10N</u> | R <u>10W</u> | <u>L-13</u> |
| | T _____ | R _____ | _____ |
| | T _____ | R _____ | _____ |
| | T _____ | R _____ | _____ |
| 2. Property Controlling in Section | S _____ | T _____ | R _____ |
| | S _____ | T _____ | R _____ |
| 3. Miscellaneous Property in Sec. | S _____ | T _____ | R _____ |
| | S _____ | T _____ | R _____ |

REG. OF DEEDS

[Signature]

STATE OF MICHIGAN
COUNTY OF KENT
RECEIVED FOR RECORD
1999 DEC - 8 AM 10: 01


11523

Register of Deeds Stamp & File Number

- 4. Lot No. _____, Recorded Plat _____
- 5. Private Claims _____

I, Randy Kolehouse, in a field survey on April 4 19 99, do hereby certify that under requirements of P.A. 74 Michigan P.A. of 1970, the corner points mentioned in lines 1 and 2 above were in conformance with regulations and rules therefore as required in the current manual of survey instructions of the United States Department of the interior, Bureau of Land Management or by a decree of a Court of Law and/or that the corner points mentioned in lines 3, 4 and 5 above were in conformance with the rules of the Michigan Board of Land Surveyors or by a Decree of a Court of Law; established, re-established, monumented, re-monumented, recovered, found as expressed below.

NOTE: Not more than 4 corners, all in the same town and range, may be recorded on this certificate.

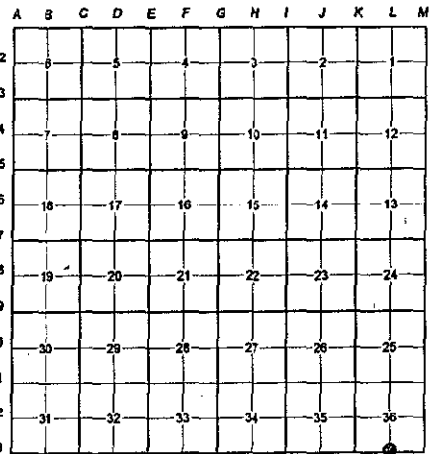

A. Description of original monument and accessories and/or subsequent restoration:

| | | | | |
|------|------|----------------|------------------|------------------------------------|
| L-13 | 1837 | G.L.O. Notes | Cathcart | Set Post |
| | 1909 | Notes | Williams & Works | Set Broken Concrete |
| | 1934 | Witness Map | K.C. Surveyor | Piece of Concrete |
| | 1967 | Records | Consumers Power | Iron Over Concrete |
| | 1986 | L.C.R.C. #4442 | Randy Kolehouse | Fnd. 3/4" Iron / Set K.C. Monument |
| | 1988 | L.C.R.C. #4780 | John Bueche | K.C. Monument |

P.A. 345 1990 KENT COUNTY
PEER APPROVED 10/28/99
CHAIRMAN [Signature]

Note: This corner is not common with L-1, T9N, R10W.

This corner was originally approved by the Kent County Remonumentation Peer Group and monumented by Randy Kolehouse in May of 1986 and was recorded per L.C.R.C. #4442.

B. Description of corner evidence found and/or method applied in restoring or reestablishing corner:

L-13 Found a Standard Kent County Monument on the C/L of 16 Mile Road (gravel) running East and West and 99' ± West of Crinnion Avenue (gravel) running South per L.C.R.C.'s #4442 and #4780 as set by Randy Kolehouse in place of a 3/4" iron he found which checked Consumers Power, Williams & Works, and the K.C. Surveyor's records.

L.C.R.C. #4442

- Nail & K.C. Remon. tag in N. side 30" Oak S 70° E 48.75'
- Nail & K.C. Remon. tag in S. side 10" Elm N 45° E 30.15'
- Nail & K.C. Remon. tag in N. side 4" Ash S 70° W 72.55'
- Rebar North 32.98'
- K.C. Remon. at N 1/4 cor. section 1 T 9 N R 10 W East 121.8'

L.C.R.C. #4780


- Nail & K.C. Remon tag in N sde 332" Oak S 70 E 48.75'
- Nail & K.C. Remon tag in S sde 12" Elm N 60 E 30.15' (m. 30.24')
- Nail & K.C. Remon tag in N sde 6" Ash S 70 W 72.55' (m. 72.45')
- Rebar North 32.98' (m. 33.09')
- K.C. Remon at N 1/4 Sec 1, T9N, R10W, East 121.8' (m. 121.98')

The selected location is accepted by me and is generally accepted by professional surveyors as the best available evidence of the position of the original corner.

C. Description of monument for corner and accessories established to perpetuate locating the position of the corner:

L-13 Standard Kent County Monument

- Nail & K.C. remon. tag on N side 32" Oak S 70° E 48.75'
- Nail & K.C. remon. tag on S side 12" Elm N 60° E 30.24'
- Nail & K.C. remon. tag on N side 6" Ash S 70° W 72.45'
- Nail & K.C. remon. tag on N side 15" Pine N 65° W 124.85'
- On C/L of gravel road running E-W
- C/L of gravel road running S, East 99' ±
- K.C. Mon. L-1, T9N, R10W, East 121.98'

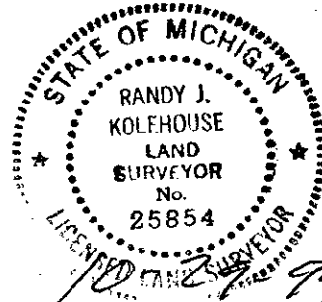

Signed by [Signature] Date _____

WILLIAMS & WORKS

Surveyor's Michigan License No. 25854