

\$7.00
\$2.00

MAY 28 2000

KENT COUNTY REMONUMENTATION

SECTION

LAND CORNER RECORDATION CERTIFICATE
Filing Requirement of Act 74, Mich. P.A. 1970

For corners in

KENT COUNTY

(County)

Located in:

Corner Code #

Tyrone Twp.

1. Public Land Survey

T 10N R 12 W	M-9
T R	Common with
T10N R 11W	A-9 Solon
T R	
S T R	
S T R	
S T R	
S T R	

2. Property Controlling in Section

3. Miscellaneous Property in Sec.

4. Lot No. _____, Recorded Plat _____
5. Private Claims _____

STATE OF MICHIGAN
COUNTY OF KENT
RECEIVED FOR RECORD

1999 MAR 24 AM 9:01

REG. OF DEEDS

11205

Register of Deeds Stamp & File Number

A	B	C	D	E	F	G	H	I	J	K	L	M
1												
2	6	5	4	3	2	1						
3												
4	7	8	9	10	11	12						
5												
6	18	17	16	15	14	13						
7												
8	19	20	21	22	23	24						
9												
10	30	29	28	27	26	25						
11												
12	31	32	33	34	35	36						
13												

I, Kirk Breitels, in a field survey on Jan. 25, 1999 do hereby state that under requirements of P.A. 74, Michigan P.A. of 1970, the corner points mentioned in lines 1 and 2 above were in conformance with regulations and rules therefore as required in the current manual of survey instructions of the United States Department of the Interior, Bureau of Land Management or by a decree of a Court of Law and /or that the corner points mentioned in lines 3, 4 and 5 above were in conformance with the rules of the Michigan Board of Land Surveyors or by a Decree of a Court of Law; established, re-established, monumented, recovered, found as expressed below:

NOTE: Not more than 2 corners, all in the same town and range, may be recorded on this certificate.

A. Description of original monument and accessories and/or subsequent restoration:

M-9 1837	GLO	Brookfield	Set Post
	Kent Co. Wits		1" Iron
1980	LCRC #1411	Bissell	1" Iron
1983	LCRC #3247	Byl	Set Kent County Monument
1991	LCRC #6045	Byl	Kent County Monument

P.A. 345 1990 KENT COUNTY
PEER APPROVED 2/25/99
CHAIRMAN *[Signature]*

The position of this corner was previously approved by the Kent County Remonumentation Peer Group, monumented by William R. Byl on 2-28-83 and was recorded per LCRC #3247.

B. Description of corner evidence found and/or method applied in restoring or reestablishing corner:


M-9 Found Kent County Monument (Harrison) per witnesses from above LCRC as set by William R. Byl in place of the 1 1/2" Iron Pipe he found. Said Iron Pipe checks with Kent Co. Wit. and LCRC #1411.

LCRC #3247		LCRC #6045	
Nail & Remon. tag 8" Oak	S30°W 59.87'	Nail & Remon. tag 10" Oak	S40°W 69.88'
Nail & Remon. tag 12" Pine	N45°W 56.60'	Nail & Remon. tag 14" Pine	N45°W 56.63'
Nail & Remon. tag 10" Oak	N55°E 78.94'	Nail & Remon. tag 12" Oak	N55°E 78.94'
Nail & Remon. tag 10" Twin Oak	S45°E 51.35'	Nail & Remon. tag 12" Twin Oak	S45°E 51.35'

The selected location is accepted by me and is generally accepted by professional surveyors as the best available evidence of the position of the original corner.

C. Description of monument for corner and accessories established to perpetuate locating the position of the corner:

M-9 Standard Kent County Monument	
Nail & KC Remon...tag NE side 14" Pine	N55°W 73.96'
Nail & KC Remon. tag SE side 16" Oak	S50°W 62.54'
Nail & KC Remon. tag S. side 14" Oak	N55°E 78.96'
Nail & KC Remon. tag N. side 12" Twin Oak	S45°E 51.33'

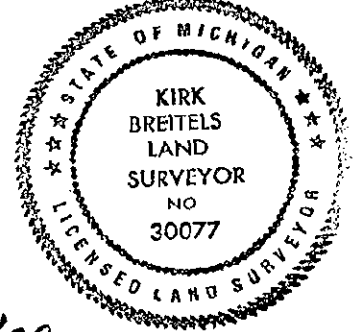

Signed by *[Signature]*
Surveyor's Michigan License No. 30077

Date 2/25/99