

**SURVEY & REMONUMENTATION**

**\$7.00**  
**\$2.00**

SEP 18 1995  
COMMISSION

**KENT COUNTY REMONUMENTATION**

STATE OF MICHIGAN  
COUNTY OF KENT  
RECEIVED FOR RECORD

**LAND CORNER RECORDATION CERTIFICATE**  
Filing Requirement of Act 74, Mich. P.A. 1970

95 MAY 12 AM 10:43

For corners in  
**KENT COUNTY**  
(County)

Located In: Corner Code #

- |                                       |                         |       |
|---------------------------------------|-------------------------|-------|
| 1. Public Land Survey                 | T 10N R 11W             | B-7   |
|                                       | T _____ R _____         | _____ |
|                                       | T _____ R _____         | _____ |
|                                       | T _____ R _____         | _____ |
| 2. Property Controlling in Section    | S _____ T _____ R _____ | _____ |
|                                       | S _____ T _____ R _____ | _____ |
| 3. Miscellaneous Property in Sec.     | S _____ T _____ R _____ | _____ |
|                                       | S _____ T _____ R _____ | _____ |
| 4. Lot No. _____, Recorded Plat _____ |                         |       |
| 5. Private Claims _____               |                         |       |

*Twiggland*  
REG. OF DEEDS

8359

Register of Deeds Stamp & File Number

I, Kirk Breitels, in a field survey on Feb. 20, 19 95, do hereby certify that under requirements of P.A. 74, Michigan P.A. of 1970, the corner points mentioned in lines 1 and 2 above were in conformance with regulations and rules therefore as required in the current manual of survey instructions of the United States Department of the Interior, Bureau of Land Management or by a decree of a Court of Law and/or that the corner points mentioned in lines 3, 4 and 5 above were in conformance with the rules of the Michigan Board of Land Surveyors or by a Decree of a Court of Law; established, re-established, monumented, re-monumented, recovered, found as expressed below:

**NOTE: Not more than 4 corners, all in the same town and range, may be recorded on this certificate.**

**A. Description of original monument and accessories and/or subsequent restoration:**

B-7	1837	GLO	Cathcart	Set Post
		Kent Co. Wit.		Leaded Stone
	1980	LCRC #1414	Bissell	1/2" Pipe
	1981	LCRC #1621	Hackbardt	1/2" Iron
	1981	LCRC #2118	Jonker	Set Kent County Monument

P.A. 345 1990 KENT COUNTY  
PEER APPROVED 4/27/95  
CHAIRMAN *Frank Thesbee*

The position of this corner was previously approved by the Kent County Remonumentation Peer Group, monumented by Robert J. Jonker on 9/11/81 and was recorded per LCRC #2118.

**B. Description of corner evidence found and/or method applied in restoring or reestablishing corner:**


B-7 Found standard Kent Co. Mon. (Harrison) per witnesses from above LCRC as set by Robert J. Jonker in place of the 1/2" Iron he found over a leaded stone. Said Iron and Stone checks with Kent Co. Wit. and LCRC's #1414 & #1621.  
LCRC #2118

DNR tag NE side P. Pole	S65°E	122.51'
DNR tag NW side P. Pole	S70°W	106.90'
NW cor. tower leg (2' above grd.)	S10°E	76.04'
Face gas line pipe	N63°W	91.67'
C/L E-W B.T. - South 2' m/l; C/L tower line - East 20.5' m/l		
On N-S fence line		

The selected location is accepted by me and is generally accepted by professional surveyors as the best available evidence of the position of the original corner.

**C. Description of monument for corner and accessories established to perpetuate locating the position of the corner:**

B-7 Standard Kent County Monument		
Set Nail & KC Remon. tag NE side P. Pole	S65°E	122.87'
Set Nail & KC Remon. tag NW side P. Pole	S70°W	105.14'
Set Nail & KC Remon. tag SE side P. Pole	N70°E	135.62'
NW cor. tower leg (2' above grd.)	S10°E	76.04'
Face gas line pipe	N63°W	91.64'
C/L E-W B.T. - South 2' m/l; C/L tower line - East 20.5' m/l		
On N-S fence line		

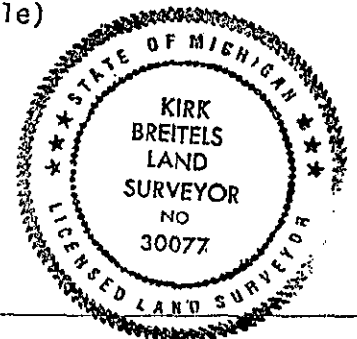

Signed by Kirk Breitels

Date 4/20/95

Surveyor's Michigan License No. 30077