

STATE OF MICHIGAN
COUNTY OF KENT
RECEIVED FOR RECORD

SEP 18 1995
\$7.00
\$2.00 COMMISSION

KENT COUNTY REMONUMENTATION

LAND CORNER RECORDATION CERTIFICATE
Filing Requirement of Act 74, Mich. P.A. 1970

95 MAY 12 AM 10:43

W. J. Bond
REG. OF DEEDS


For corners in
KENT COUNTY
(County)

	Located In:	Corner Code #
1. Public Land Survey	T 10N R 11W	C-5
	T _____ R _____	_____
	T _____ R _____	_____
	T _____ R _____	_____
2. Property Controlling in Section	S _____ T _____ R _____	_____
	S _____ T _____ R _____	_____
3. Miscellaneous Property in Sec.	S _____ T _____ R _____	_____
	S _____ T _____ R _____	_____

8366

Register of Deeds Stamp & File Number

- 4. Lot No. _____, Recorded Plat _____
- 5. Private Claims _____

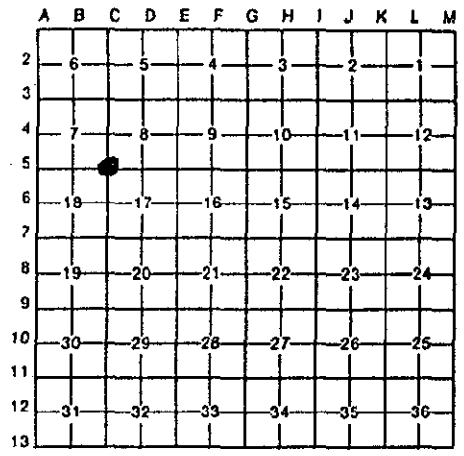

I, Kirk Breitels, in a field survey on Feb. 21, 19 95, do hereby certify that under requirements of P.A. 74, Michigan P.A. of 1970, the corner points mentioned in lines 1 and 2 above were in conformance with regulations and rules therefore as required in the current manual of survey instructions of the United States Department of the Interior, Bureau of Land Management or by a decree of a Court of Law and/or that the corner points mentioned in lines 3, 4 and 5 above were in conformance with the rules of the Michigan Board of Land Surveyors or by a Decree of a Court of Law: established, re-established, monumented, re-monumented, recovered, found as expressed below:

NOTE: Not more than 4 corners, all in the same town and range, may be recorded on this certificate.

A. Description of original monument and accessories and/or subsequent restoration:

C-5	1837 GLO	Cathcart	Set Post
	1907-59 Williams & Works		Pine Root-Iron
	1964 Kent Co. Wit.		3/4" Iron
	1984 LCRC #3796	Kolehouse	Set Kent County Monument

The position of this corner was previously approved by the Kent County Remonumentation Peer Group, monumented by Randy J. Kolehouse on 3/10/84 and was recorded per LCRC #3796

B. Description of corner evidence found and/or method applied in restoring or reestablishing corner:

C-5 Found standard Kent Co. Mon. (Harrison) per witnesses from above LCRC as set by Randy J. Kolehouse in place of the "T" Iron he found. Said "T" Iron checks with Williams & Works information.

LCRC #3796

Nail & KC Remon. tag top guard rail post	N20°E	48.55'
Nail & KC Remon. tag top guard rail post	N70°E	52.85'
Nail & KC Remon. tag top guard rail post	S25°E	53.50'
NE cor. conc. pad to tele. box	S45°W	61.80'
At C/L "X" 20 Mile Rd. & Albrecht Ave.		

P.A. 345 1990 KENT COUNTY
 PEER APPROVED 4/27/95
 CHAIRMAN *Harry Thibodeau*

The selected location is accepted by me and is generally accepted by professional surveyors as the best available evidence of the position of the original corner.

C. Description of monument for corner and accessories established to perpetuate locating the position of the corner:

C-5 Standard Kent County Monument

Nail & KC Remon. tag top guard rail post	N20°E	48.66'
Nail & KC Remon. tag top guard rail post	N70°E	52.92'
Nail & KC Remon. tag top guard rail post	S25°E	53.57'
NE cor. conc. pad to tele. box	S45°W	61.80'
At C/L "X" 20 Mile Rd. & Albrecht Ave.		



Signed by *Kirk Breitels*

Date 4/20/95

Surveyor's Michigan License No. 30077