

SEP 18 1995

KENT COUNTY REMONUMENTATION

STATE OF MICHIGAN
COUNTY OF KENT
RECEIVED FOR RECORD

\$7.00
\$2.00 COMMISSION

LAND CORNER RECORDATION CERTIFICATE
Filing Requirement of Act 74, Mich. P.A. 1970

35 MAY 12 AM 10:43

For corners in
KENT COUNTY
(County)

Located In: Corner Code #


- 1. Public Land Survey T 10N R 11W C-7
- T _____ R _____
- T _____ R _____
- T _____ R _____
- 2. Property Controlling S _____ T _____ R _____
- in Section S _____ T _____ R _____
- 3. Miscellaneous S _____ T _____ R _____
- Property in Sec. S _____ T _____ R _____
- 4. Lot No. _____, Recorded Plat _____
- 5. Private Claims _____

W. J. Bond
REG. OF DEEDS

8368

Register of Deeds Stamp & File Number

I, Kirk Breitels, in a field survey on Feb. 21, 19 95, do hereby certify that under requirements of P.A. 74, Michigan P.A. of 1970, the corner points mentioned in lines 1 and 2 above were in conformance with regulations and rules therefore as required in the current manual of survey instructions of the United States Department of the Interior, Bureau of Land Management or by a decree of a Court of Law and/or that the corner points mentioned in lines 3, 4 and 5 above were in conformance with the rules of the Michigan Board of Land Surveyors or by a Decree of a Court of Law; established, re-established, monumented, re-monumented, recovered, found as expressed below:

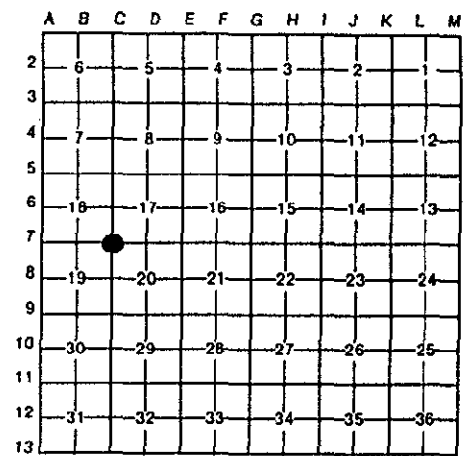

NOTE: Not more than 4 corners, all in the same town and range, may be recorded on this certificate.

A. Description of original monument and accessories and/or subsequent restoration:

- C-7 1837 GLO Cathcart Set Post
- 1901-10 Williams & Works Leaded Stone
- Kent Co. Wit. Leaded Stone
- 1983 LCRC #3682 Bueche Set Kent County Monument

The position of this corner was previously approved by the Kent County Remonumentation Peer Group, monumented by John C. Bueche on 12/6/83 and was recorded per LCRC #3682.

B. Description of corner evidence found and/or method applied in restoring or reestablishing corner:

C-7 Found standard Kent Co. Mon. (Harrison) per witnesses from above LCRC as set by John C. Bueche in place of the 1" Iron he found inside a 1 1/2" Iron over leaded stone. Both Irons and stone check with Kent Co. Wit. & Williams & Works information.

LCRC #3682

- KC Remon. tag & nail N. side 18" Oak S80°W 188.86' P.A. 345 1990 KENT COUNTY
- KC Remon. tag & nail N. side 42" Oak S65°E 82.92' PEER APPROVED 4/27/95
- KC Remon. tag & nail S. side 30" Maple N80°E 139.83' CHAIRMAN James H. Huer
- KC Remon. tag & nail W. side 24" Oak S10°W 68.66'
- C/L blacktop road E-W - South 3.5' m/l; C/L blacktop road North - West 4.5' m/l

The selected location is accepted by me and is generally accepted by professional surveyors as the best available evidence of the position of the original corner.

C. Description of monument for corner and accessories established to perpetuate locating the position of the corner:

C-7 Standard Kent County Monument

- New KC Remon. tag & nail N. side 48" Oak S65°E 82.91'
- New KC Remon. tag & nail S. side 40" Maple N80°E 141.18'
- New KC Remon. tag & nail W. side 30" Oak S10°W 68.65'
- C/L blacktop road E-W - South 3.5' m/l; C/L blacktop road North - West 4.5' m/l

Signed by Kirk Breitels

Date 4/20/95

Surveyor's Michigan License No. 30077

