SURVEYS
REMONUMENTATION

MAY 22 2000

$7.00
$2.00

SECTION

KENT COUNTY REMONUMENTATION

LAND CORNER RECORDATION CERTIFICATE
Filing Requirement of Act 74, Mich. P.A. 1970

STATE OF MICHIGAN
COUNTY OF KENT
RECEIVED FOR RECORD
1999 DEC 15 AM 8:55

REG. OF DEEDS

11588

Register of Deeds Stamp & File Number

For corners in
KENT COUNTY
(County)

	Located In:			Corner Code #
				Solon Twp.
1. Public Land Survey		T 10N	R 11W	D-6
		T___	R___	
		T___	R___	
		T___	R___	
2. Property Controlling	S___	T___	R___	
in Section	S___	T___	R___	
3. Miscellaneous	S___	T___	R___	
Property in Sec.	S___	T___	R___	

4. Lot No. _____ , Recorded Plat _____
5. Private Claims _____

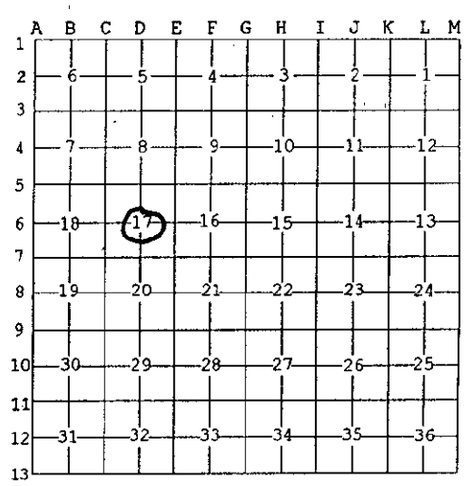

I, Kirk Breitels, in a field survey on Aug. 30, 19 99 do hereby state that under requirements of P.A. 74, Michigan P.A. of 1970, the corner points mentioned in lines 1 and 2 above were in conformance with regulations and rules therefore as required in the current manual of survey instructions of the United States Department of the Interior, Bureau of Land Management or by a decree of a Court of Law and /or that the corner points mentioned in lines 3, 4 and 5 above were in conformance with the rules of the Michigan Board of Land Surveyors or by a Decree of a Court of Law; established, re-established, monumented, recovered, found as expressed below:

NOTE: Not more than 2 corners, all in the same town and range, may be recorded on this certificate.

A. Description of original monument and accessories and/or subsequent restoration:

D-6	1837	GLO	Not Set
	1964	Williams & Works	Computed location
		Kent Co. Wits	No information

P.A. 345 1990 KENT COUNTY
PEER APPROVED 10/28/99
CHAIRMAN Harry Huber

B. Description of corner evidence found and/or method applied in restoring or reestablishing corner:

D-6 Established Intersection of 1/4 lines and found remains of fence to South to be 6' ± East and remains of fence to West to be 4' ± South. Location agrees with measurements of surveys by Hackbardt, W. Glaza and Williams & Works computations.

The Intersection of 1/4 lines is accepted by me and is generally accepted by professional surveyors as the best available evidence of the position of the corner.

C. Description of monument for corner and accessories established to perpetuate locating the position of the corner:

D-6 Set Standard Kent County Monument at the Intersection of 1/4 lines.

Nail & KC Remon. tag SE side 24" Beech	S80°W	47.48'
Nail & KC Remon. tag NE side 28" Beech	N40°W	41.40'
Nail & KC Remon. tag W. side 36" Beech	N30°E	31.73'
Nail & KC Remon. tag NE side 12" Beech	S40°E	19.72'
Nail & KC Remon. tag W. side 24" Beech	S05°E	44.77'

STATE OF MICHIGAN
KIRK BREITELS
LAND SURVEYOR
NO
30077
LICENSED LAND SURVEYOR

Signed by Kirk Breitels
Date 12/6/99
Surveyor's Michigan License No. 30077

FORM APPROVED BY MICHIGAN STATE BOARD OF PROFESSIONAL SURVEYORS, JAN. 28, 1971
REVISED MAY 14, 1975
REVISED JAN., 1983
REVISED OCT., 1995