

SURVEY  
REMONUMENTATION

SEP 18 1935

\$7.00  
\$2.00

KENT COUNTY REMONUMENTATION

STATE OF MICHIGAN  
COUNTY OF KENT  
RECEIVED FOR RECORD

95 MAY 12 AM 10:44

LAND CORNER RECORDATION CERTIFICATE  
Filing Requirement of Act 74, Mich. P.A. 1970

*Lucy Bond*  
REG. OF DEEDS

For corners in  
KENT COUNTY

(County)	Located In:	Corner Code #
1. Public Land Survey	T <u>10N</u> R <u>11W</u>	E-5
	T _____ R _____	_____
	T _____ R _____	_____
	T _____ R _____	_____
2. Property Controlling in Section	S _____ T _____ R _____	_____
	S _____ T _____ R _____	_____
3. Miscellaneous Property in Sec.	S _____ T _____ R _____	_____
	S _____ T _____ R _____	_____
4. Lot No. _____, Recorded Plat _____		
5. Private Claims _____		

8385

Register of Deeds Stamp & File Number

I, Kirk Breitels, in a field survey on Feb. 22, 1995

do hereby certify that under requirements of P.A. 74, Michigan P.A. of 1970, the corner points mentioned in lines 1 and 2 above were in conformance with regulations and rules therefore as required in the current manual of survey instructions of the United States Department of the Interior, Bureau of Land Management or by a decree of a Court of Law and/or that the corner points mentioned in lines 3, 4 and 5 above were in conformance with the rules of the Michigan Board of Land Surveyors or by a Decree of a Court of Law; established, re-established, monumented, re-monumented, recovered, found as expressed below:

NOTE: Not more than 4 corners, all in the same town and range, may be recorded on this certificate.

A. Description of original monument and accessories and/or subsequent restoration:

E-5	1837	GLO	Cathcart	Set Post
	1964	Williams & Works		Well Point
	1965	Kent Co. Wit.		2" Iron
	1975	LCRC #3236	Bonnema	3/4" Iron in mon. box
	1984	LCRC #3743	Meyer	Set Kent County Monument in mon. box

The position of this corner was previously approved by the Kent County Remonumentation Peer Group, monumented by Allan L. Meyer on 2/21/84 and was recorded per LCRC #3743

B. Description of corner evidence found and/or method applied in restoring or reestablishing corner:

E-5 Found standard Kent Co. Mon. (Harrison) per witnesses from above LCRC as set by Allan L. Meyer in place of the 2" dia. well point he found underneath 3/4" Iron in mon. box. Said 2" dia. well point checks with Kent Co. Wit. and Williams & Works information. 3/4" Iron in mon. box was 0.3' West.

LCRC #3743

Nail & KC Remon. tag W. side large fence post	N14°E	124.61'
Nail & KC Remon. tag S. side large fence post	N78°E	121.00'
Nail & KC Remon. tag SE side Power Pole	S50°W	96.07'
Nail & KC Remon. tag SW side Power Pole	N35°W	100.00'
C/L steel street sign post (at ground)	S45°E	41.32'
Top C/L MBT Co. box	N78°W	51.56'

On C/L blacktop road E-W and on C/L gravel road N-S


The selected location is accepted by me and is generally accepted by professional surveyors as the best available evidence of the position of the original corner.

C. Description of monument for corner and accessories established to perpetuate locating the position of the corner:

E-5 Standard Kent County Monument

Set Nail & KC Remon. tag W. side 40" Oak	N10°E	145.95'
Set PK Nail & KC Remon. tag in curb joint	S30°E	37.65'
Nail & KC Remon. tag SE side P. Pole	S50°W	96.11'
Nail & KC Remon. tag SW side P. Pole (new)	N35°W	98.10'

On C/L blacktop road E-W and on C/L gravel road N-S

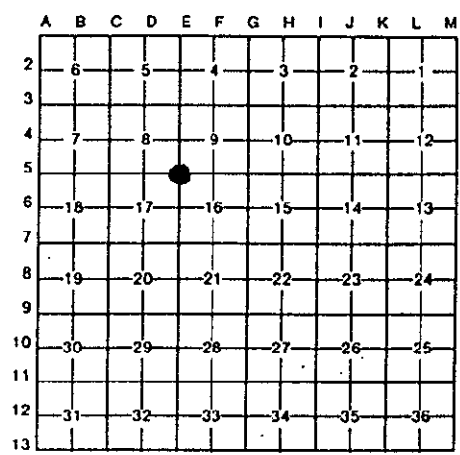

Signed by Kirk Breitels

Date 4/20/95

Surveyor's Michigan License No. 30077