

\$7.00 18 1995

\$2.00
COMMISSION

KENT COUNTY REMONUMENTATION

STATE OF MICHIGAN
COUNTY OF KENT
RECEIVED FOR RECORD

95 MAY 12 AM 10:44

LAND CORNER RECORDATION CERTIFICATE

Filing Requirement of Act 74, Mich. P.A. 1970


W. J. Bond
REG. OF DEEDS

For corners in
KENT COUNTY

(County)	Located In:	Corner Code #
1. Public Land Survey	T <u>10N</u> R <u>11W</u>	E-7
	T _____ R _____	_____
	T _____ R _____	_____
	T _____ R _____	_____
2. Property Controlling in Section	S _____ T _____ R _____	_____
	S _____ T _____ R _____	_____
3. Miscellaneous Property in Sec.	S _____ T _____ R _____	_____
	S _____ T _____ R _____	_____
4. Lot No. _____, Recorded Plat _____		
5. Private Claims _____		

8387

Register of Deeds Stamp & File Number

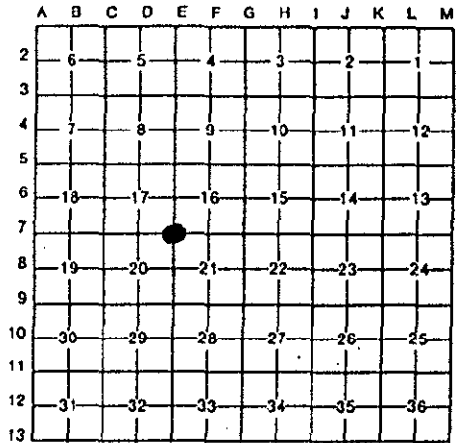

I, Kirk Breitels in a field survey on Feb. 22, 19 95

do hereby certify that under requirements of P.A. 74, Michigan P.A. of 1970, the corner points mentioned in lines 1 and 2 above were in conformance with regulations and rules therefore as required in the current manual of survey instructions of the United States Department of the Interior, Bureau of Land Management or by a decree of a Court of Law and/or that the corner points mentioned in lines 3, 4 and 5 above were in conformance with the rules of the Michigan Board of Land Surveyors or by a Decree of a Court of Law; established, re-established, monumented, re-monumented, recovered, found as expressed below:

NOTE: Not more than 4 corners, all in the same town and range, may be recorded on this certificate.

A. Description of original monument and accessories and/or subsequent restoration:

E-7	1837	GLO	Cathcart	Set Post
	1965	Kent Co. Wit.		Leaded Stone
	1981	LCRC #2092	Nederveld	Solid Iron
	1982	LCRC #2904	Jonker	Set Kent County Monument

The position of this corner was previously approved by the Kent County Remonumentation Peer Group, monumented by Robert J. Jonker on 6/10/82 and was recorded per LCRC #2903.

B. Description of corner evidence found and/or method applied in restoring or reestablishing corner:

E-7 Found standard BROKEN Kent Co. Mon. (Harrison) per witnesses from above LCRC as set by Robert J. Jonker in place of the Boat Spike he found over an 8" x 10" x 24" stone. Said Boat Spike & Stone check with Kent Co. Wit. and LCRC #2092.

LCRC #2904

- Remon. tag NE side P. Pole N55°W 64.55'
- NW cor. conc. slab to Util. Ped. S40°E 46.58'
- Chiseled "X" on E. end culvert N10°E 108.74'
- "L" Iron - South 32.97'
- On C/L E-W pavement, in line with C/L gravel to N.

P.A. 345 1990 KENT COUNTY
PEER APPROVED 4/27/95
CHAIRMAN *Harry Huber*

The selected location is accepted by me and is generally accepted by professional surveyors as the best available evidence of the position of the original corner.

C. Description of monument for corner and accessories established to perpetuate locating the position of the corner:

E-7 Removed and replaced broken portion of Standard Kent County Monument.

- Nail & KC Remon. tag NE side P. Pole N55°W 64.60'
- NW cor. conc. slab to Util. Ped. S40°E 49.50' (new box)
- SW side steel fence post N25°E 47.60'
- C/L E. end culvert N10°E 108.5'
- "L" Iron - South 32.95'
- On C/L E-W pavement, in line with C/L gravel to N.



Signed by *Kirk Breitels* Date 4/20/95
Surveyor's Michigan License No. 30077