

\$7.00 SEP 18 1995
\$2.00 COMMISSION

KENT COUNTY REMONUMENTATION

LAND CORNER RECORDATION CERTIFICATE
Filing Requirement of Act 74, Mich. P.A. 1970

STATE OF MICHIGAN
COUNTY OF KENT
RECEIVED FOR RECORD
95 MAY 12 AM 10:45

Lucy Bond
REG. OF DEEDS

8390

Register of Deeds Stamp & File Number


For corners in
KENT COUNTY

(County)

1. Public Land Survey	Located In: T <u>10N</u> R <u>11W</u>	Corner Code # <u>E-10</u>
	T _____ R _____	_____
	T _____ R _____	_____
	T _____ R _____	_____
2. Property Controlling in Section	S _____ T _____ R _____	_____
	S _____ T _____ R _____	_____
3. Miscellaneous Property in Sec.	S _____ T _____ R _____	_____
	S _____ T _____ R _____	_____

4. Lot No. _____, Recorded Plat _____

5. Private Claims _____

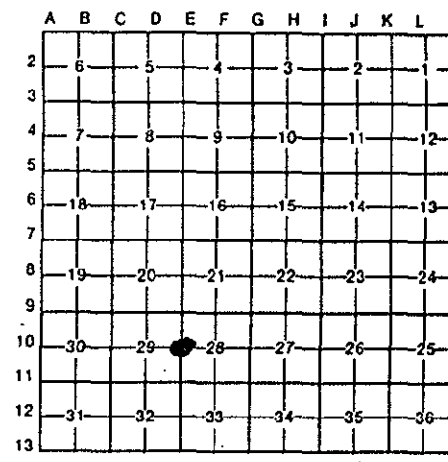

I, Kirk Breitels, in a field survey on Feb. 22, 19 95, do hereby certify that under requirements of P.A. 74, Michigan P.A. of 1970, the corner points mentioned in lines 1 and 2 above were in conformance with regulations and rules therefore as required in the current manual of survey instructions of the United States Department of the Interior, Bureau of Land Management or by a decree of a Court of Law and/or that the corner points mentioned in lines 3, 4 and 5 above were in conformance with the rules of the Michigan Board of Land Surveyors or by a Decree of a Court of Law; established, re-established, monumented, re-monumented, recovered, found as expressed below:

NOTE: Not more than 4 corners, all in the same town and range, may be recorded on this certificate.

A. Description of original monument and accessories and/or subsequent restoration:

E-10	1837	GLO	Cathcart	Set Post
	1941	Kent Co. Wit.		Iron
	1971	LCRC #87	Spicer	Iron Pipe in mon. box
	1979	LCRC #1285	Reda	Iron & cap
	1981	LCRC #2112	Jonker	Set Kent County Monument

The position of this corner was previously approved by the Kent County Remonumentation Peer Group, monumented by Robert J. Jonker on 9/24/81 and was recorded per LCRC #2112.

B. Description of corner evidence found and/or method applied in restoring or reestablishing corner:

E-10 Found standard Kent Co. Mon. (Harrison) per witnesses from above LCRC as set by Robert J. Jonker in place of the 3/8" Rerod he found. Said Rerod checks with Kent Co. Wit. and LCRC's #87 & #1285.

LCRC #2112

Remon. tag E. side Tw. 10" Box Elder	N06°E	79.45'
Remon. tag S. side Guy Pole	S84°W	163.03'
NE corner hse. fnd.	S71°W	224.10'
Iron	North	33.03'

In line fence & tree line to North; C/L E-W B.T. is South 3' m/1

P.A. 345 1990 KENT COUNTY
PEER APPROVED 4/27/95
CHAIRMAN *Harry Kupers*


The selected location is accepted by me and is generally accepted by professional surveyors as the best available evidence of the position of the original corner.

C. Description of monument for corner and accessories established to perpetuate locating the position of the corner:

E-10 Standard Kent County Monument

New Nail & KC Remon. tag E. side Tw. 16" Box Elder	N06°E	79.00'
Nail & KC Remon. tag S. side Guy Pole	S84°W	162.94'
Set Nail & KC Remon. tag W. side 8" Maple	S45°W	64.38'
Set Nail & KC Remon. tag E. side 6" Apple	S30°E	52.45'
NE corner hse. fnd.	S71°W	224.10'
Iron - North		33.03'

In line fence & tree line to North; C/L E-W B.T. is South 3' m/1

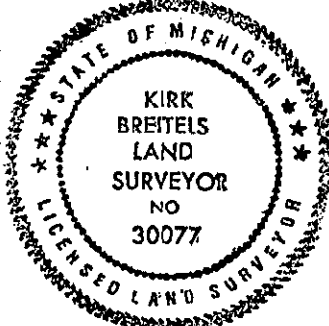

Signed by *Kirk Breitels* Date 4/20/95
Surveyor's Michigan License No. 30077