

LAND CORNER RECORDATION CERTIFICATE
Filing Requirement of Act 74, Mich. P.A. 1970

REC'D
 93 AUG 26

For corners in

Kent

(County)

Located In:

SOLON TOWNSHIP
 Corner Code 77

- | | | |
|------------------------------------|-------------------------|-----|
| 1. Public Land Survey | T 10N R 11W | F-2 |
| | T _____ R _____ | |
| | T _____ R _____ | |
| | T _____ R _____ | |
| 2. Property Controlling in Section | S _____ T _____ R _____ | |
| | S _____ T _____ R _____ | |
| 3. Miscellaneous Property in Sec | S _____ T _____ R _____ | |
| | S _____ T _____ R _____ | |

REG. NO. 6805

Register of Deeds Stamp & File Number

4. Lot No _____, Recorded Plat _____
 5. Private Claims _____

	A	B	C	D	E	F	G	H	I	J	K	L	M
2	6		5		•		3			2			1
3													
4	7		8		3		10			11			12
5													
6	18		17		16		15			14			13
7													
8	19		20		21		22			23			24
9													
10	30		29		28		27			25			25
11													
12	31		32		33		34			35			36
13													

I, Wallace E. Glaza, in a field survey on July 22, 1993, do hereby certify that under requirements of P.A. 74, Michigan P.A. of 1970, the corner points mentioned in lines 1 and 2 above were in conformance with regulations and rules therefore as required in the current manual of survey instructions of the United States Department of the Interior, Bureau of Land Management or by a decree of a Court of Law and/or that the corner points mentioned in lines 3, 4 and 5 above were in conformance with the rules of the Michigan Board of Land Surveyors or by a Decree of a Court of Law; established, re-established, monumented, re-monumented, recovered, found as expressed below:

NOTE: Not more than 4 corners, all in the same town and range, may be recorded on this certificate.

A. Description of original monument and accessories and/or subsequent restoration:

No previous information.

B. Description of corner evidence found and/or method applied in restoring or reestablishing corner:

F-2 (Center of Section 4, T10N, R11W, Solon Township, Kent County, Michigan)


Set standard 4" x 30" Harrison Monument at intersection of 1/4 lines.

- South 1/4 corner to center - 2652.34'
- West 1/4 corner to center - 2640.35'
- North 1/4 corner to center - 3444.35'
- East 1/4 corner to center - 2647.52'

C. Description of monument for corner and accessories established to perpetuate locating the position of the corner:

F-2 (Standard 4" x 30" Harrison Monument)

- 1) Nail and tag in W side 12" Oak N16°W 27.06'
- 2) Nail and tag in N side 18" Maple S89°E 69.00'
- 3) Nail and tag in W side 6" Hickory S00°W 64.54'
- 4) Nail and tag in SE side 12" Willow S52°W 34.50'

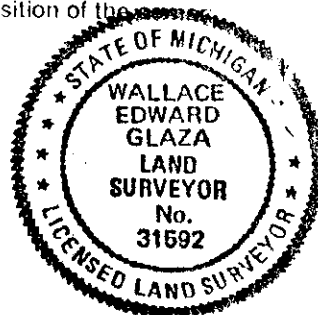

Signed by Wallace E. Glaza
 Glaza and Associates, Inc. 31592

Date 8-9-93