

MAY 22 2000

KENT COUNTY REMONUMENTATION

\$1.00
\$2.00

SECTION

LAND CORNER RECORDATION CERTIFICATE
Filing Requirement of Act 74, Mich. P.A. 1970

For corners in

<u>KENT COUNTY</u> (County)	Located in:	Corner Code #
		Solon Twp.
1. Public Land Survey	T <u>10</u> N R <u>11</u> W	<u>F-4</u>
	T <u> </u> R <u> </u>	<u> </u>
	T <u> </u> R <u> </u>	<u> </u>
	T <u> </u> R <u> </u>	<u> </u>
2. Property Controlling in Section	S <u> </u> T <u> </u> R <u> </u>	<u> </u>
	S <u> </u> T <u> </u> R <u> </u>	<u> </u>
3. Miscellaneous Property in Sec.	S <u> </u> T <u> </u> R <u> </u>	<u> </u>
	S <u> </u> T <u> </u> R <u> </u>	<u> </u>

REG. OF DEEDS

[Signature]

STATE OF MICHIGAN
COUNTY OF KENT
RECEIVED FOR RECORD
1999 NOV -4 AM 8:35

11457

Register of Deeds Stamp & File Number

4. Lot No. _____, Recorded Plat _____
5. Private Claims _____

I, Kirk Breitels, in a field survey on Aug. 10, 1999 do hereby state that under requirements of P.A. 74, Michigan P.A. of 1970, the corner points mentioned in lines 1 and 2 above were in conformance with regulations and rules therefore as required in the current manual of survey instructions of the United States Department of the Interior, Bureau of Land Management or by a decree of a Court of Law and /or that the corner points mentioned in lines 3, 4 and 5 above were in conformance with the rules of the Michigan Board of Land Surveyors or by a Decree of a Court of Law; established, re-established, monumented, recovered, found as expressed below:

A	B	C	D	E	F	G	H	I	J	K	L	M
1												
2	6	5	4	3	2	1						
3												
4	7	8	9	10	11	12						
5												
6	18	17	16	15	14	13						
7												
8	19	20	21	22	23	24						
9												
10	30	29	28	27	26	25						
11												
12	31	32	33	34	35	36						
13												

NOTE: Not more than 2 corners, all in the same town and range, may be recorded on this certificate.

A. Description of original monument and accessories and/or subsequent restoration:

F-4 1837 GLO
1900 Williams & Works
Kent Co. Wits
1997 Survey Glaza & Assoc.

Not Set
Stone
No information

P.A. 345 1900 KENT COUNTY

PEER APPROVED 8/26/99
CHAIRMAN [Signature]

"Deer Run Estates" site condominium - computed intersection of 1/4 lines (under construction - Center not yet set)

B. Description of corner evidence found and/or method applied in restoring or reestablishing corner:

F-4 Found Capped Rerod (Roosien) that is 0.1' W. and less than 0.1' N. of intersection of 1/4 lines.

Measurements to Capped Rerod (Roosien) agree ± with those of Glaza & Assoc.


Old fence corner (fences down) is 5' N. and 2' W.

The Capped Rerod (Roosien) is accepted by me and is generally accepted by professional surveyors as the best available evidence of the position of the corner.

C. Description of monument for corner and accessories established to perpetuate locating the position of the corner:

F-4 Set Standard Kent County Monument in place of the Capped Rerod (Roosien)

Nail & KC Remon. tag E. side stump pole S25°W 1.83'
Nail & KC Remon. tag NE side 6" Oak S55°E 27.35'
Nail & KC Remon. tag N. side 12" Cherry N75°E 19.11'
Nail & KC Remon. tag E. side 30" Maple N05°W 24.31'
S. edge "L" fence post in conc. base N10°W 5.03'

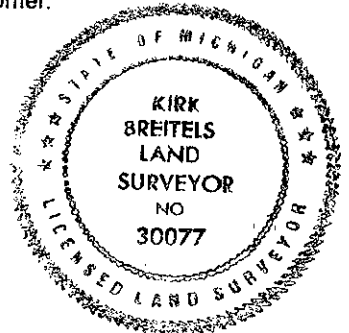

Signed by *[Signature]*
Surveyor's Michigan License No. 30077

Date 10/28/99