

\$7.00
\$2.00

MAY 22 2000

KENT COUNTY REMONUMENTATION

SECTION LAND CORNER RECORDATION CERTIFICATE
Filing Requirement of Act 74, Mich. P.A. 1970

REG. OF DEEDS

STATE OF MICHIGAN
COUNTY OF KENT
RECEIVED FOR RECORD
1999 DEC 15 AM 8:55

For corners in

KENT COUNTY (County)	Located In:	Corner Code #
1. Public Land Survey	T <u>10N</u> R <u>11W</u>	Solon Twp. E-12
	T ___ R ___	_____
	T ___ R ___	_____
	T ___ R ___	_____
2. Property Controlling in Section	S ___ T ___ R ___	_____
	S ___ T ___ R ___	_____
3. Miscellaneous Property in Sec.	S ___ T ___ R ___	_____
	S ___ T ___ R ___	_____

11591

Register of Deeds Stamp & File Number

4. Lot No. _____, Recorded Plat _____
5. Private Claims _____

I, Kirk Breitels, in a field survey on Nov. 8, 19 99 do hereby state that under requirements of P.A. 74, Michigan P.A. of 1970, the corner points mentioned in lines 1 and 2 above were in conformance with regulations and rules therefore as required in the current manual of survey instructions of the United States Department of the Interior, Bureau of Land Management or by a decree of a Court of Law and /or that the corner points mentioned in lines 3, 4 and 5 above were in conformance with the rules of the Michigan Board of Land Surveyors or by a Decree of a Court of Law; established, re-established, monumented, recovered, found as expressed below:

NOTE: Not more than 2 corners, all in the same town and range, may be recorded on this certificate.

	A	B	C	D	E	F	G	H	I	J	K	L	M
1													
2	6		5		4		3		2		1		
3													
4	7		8		9		10		11		12		
5													
6	18		17		16		15		14		13		
7													
8	19		20		21		22		23		24		
9													
10	30		29		28		27		26		25		
11													
12	31		32		33		34		35		36		
13													

A. Description of original monument and accessories and/or subsequent restoration:

F-12 1837	GLO	Not Set
1894	Williams & Works	Stake & Stone
	Kent Co. Wits.	No information

P.A. 345 1990 KENT COUNTY
PEER APPROVED 12/02/99
CHAIRMAN *[Signature]*

B. Description of corner evidence found and/or method applied in restoring or reestablishing corner:

F-12 Established Intersection of 1/4 lines and found it to be in the centerline of an old 8" diameter 4-way fence corner post. Intersection of 1/4 lines checks with minimal survey information in this section.

Set Rerod and Cap ("Kent Co. Remon.") 1' North and 1' West (Rerods on 1/4 lines) of Intersection of 1/4 lines.


The Intersection of 1/4 lines is accepted by me and is generally accepted by professional surveyors as the best available evidence of the position of the corner.

C. Description of monument for corner and accessories established to perpetuate locating the position of the corner:

F-12 NO MONUMENT SET AT THIS CORNER - falls in centerline of old 4-way fence corner post

Witnesses to Intersection of 1/4 lines.

Nail & KC Remon. tag W. side 10" Maple	N05°E	8.59'
Nail & KC Remon. tag N. side 15" Maple	N80°E	14.03'
Nail & KC Remon. tag W. side 15" Oak	S20°W	23.28'
Nail & KC Remon. tag N. side 15" Oak	N85°W	8.78'
Nail & KC Remon. tag N. side 15" Oak	S60°W	43.43'
Capped Rerod North 1.0' and West 1.0'		

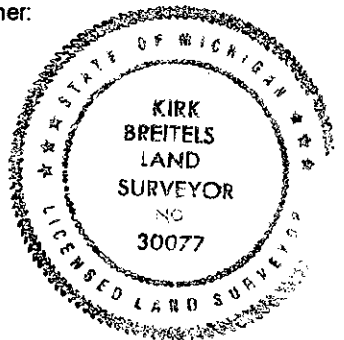

Signed by *[Signature]*
Surveyor's Michigan License No. 30077

Date 12/6/99