

SEP 18 1995

\$7.00 COMMISSION  
\$2.00

KENT COUNTY REMONUMENTATION

STATE OF MICHIGAN  
COUNTY OF KENT  
RECEIVED FOR RECORD

95 MAY 12 AM 10:46

LAND CORNER RECORDATION CERTIFICATE  
Filing Requirement of Act 74, Mich. P.A. 1970

*W. J. Bond*  
REG. OF DEEDS

For corners in  
KENT COUNTY  
(County)

	Located In:	Corner Code #
1. Public Land Survey	T 10N R 11W	G-11
	T R	
	T R	
	T R	
2. Property Controlling in Section	S T R	
	S T R	
3. Miscellaneous Property in Sec.	S T R	
	S T R	

8409

Register of Deeds Stamp & File Number

- 4. Lot No. \_\_\_\_\_, Recorded Plat \_\_\_\_\_
- 5. Private Claims \_\_\_\_\_

	A	B	C	D	E	F	G	H	I	J	K	L	M
2	6	5	4	3	2	1							
3													
4	7	8	9	10	11	12							
5													
6	18	17	16	15	14	13							
7													
8	19	20	21	22	23	24							
9													
10	30	29	28	27	26	25							
11													
12	31	32	33	34	35	36							
13													

I, Kirk Breitels, in a field survey on March 10, 1995, do hereby certify that under requirements of P.A. 74, Michigan P.A. of 1970, the corner points mentioned in lines 1 and 2 above were in conformance with regulations and rules therefore as required in the current manual of survey instructions of the United States Department of the Interior, Bureau of Land Management or by a decree of a Court of Law and/or that the corner points mentioned in lines 3, 4 and 5 above were in conformance with the rules of the Michigan Board of Land Surveyors or by a Decree of a Court of Law; established, re-established, monumented, re-monumented, recovered, found as expressed below:

NOTE: Not more than 4 corners, all in the same town and range, may be recorded on this certificate.

A. Description of original monument and accessories and/or subsequent restoration:

G-11	1837	GLO	Cathcart	Set Post
	1958	Kent Co. Wit.		Mon. Box
	1974	LCRC #655	Spicer	3/4" Iron in mon. box
	1981	LCRC #2128	Jonker	Set Kent County Monument in mon. box
	1994		Glaza	Witness Kent Co. Mon. before road const.

The position of this corner was previously approved by the Kent County Remonumentation Peer Group, monumented by Robert J. Jonker on 9/15/81 and was recorded per LCRC #2128.

B. Description of corner evidence found and/or method applied in restoring or reestablishing corner:

G-11 Found empty mon. box (after road const.). Set standard Kent Co. Mon. (Harrison) in mon. box per witnesses from Glaza and from above LCRC as set by Robert J. Jonker in place of the 3/4" iron he found inside a mon. box over a conc. mon. Said Iron and conc. mon. check with Kent Co. Wit. and LCRC #655.

LCRC #2128

Face Conc. R.O.W. marker	N33°E	52.67'
M.S.H.D. tag SW side P. Pole	S45°E	70.53'
Remon. tag NE side P. Pole	N25°W	58.01'
SW cor. conc. H/W	S75°W	56.70'

P.A. 345 1990 KENT COUNTY


PEER APPROVED 4/27/95  
CHAIRMAN Harry Fisher

On C/L "X" streets	Remon. tag & nail NW side sign post	S40°W	72.97'	(Glaza)
	Remon. tag & nail W. side 8" Aspen	N40°E	118.62'	(Glaza)

The selected location is accepted by me and is generally accepted by professional surveyors as the best available evidence of the position of the original corner.

C. Description of monument for corner and accessories established to perpetuate locating the position of the corner:

G-11 Standard Kent County Monument in mon. box				
M.S.H.D. tag SW side stump P. Pole	S45°E	70.66'		
Remon. tag & nail NE side P. Pole	N25°W	58.01'		
Remon. tag & nail NW side sign post	S40°W	72.97'		
Remon. tag & nail W. side 8" Aspen	N40°E	118.62'		
Set Remon. tag & nail NE side new P. Pole	S45°E	72.56'		
On C/L "X" streets				

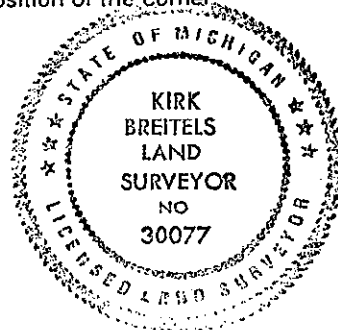

Signed by Kirk Breitels

Date 4/20/95

Surveyor's Michigan License No. 30077