SURVEY & REMONUMENTATION

MAY 22 2000

SECTION

$7.00
$2.00

KENT COUNTY REMONUMENTATION

LAND CORNER RECORDATION CERTIFICATE
Filing Requirement of Act 74, Mich. P.A. 1970

STATE OF MICHIGAN
COUNTY OF KENT
RECEIVED FOR RECORD
1999 NOV -4 AM 8:35
REG. OF DEEDS

11462
Register of Deeds Stamp & File Number

For corners in

KENT COUNTY
(County)

		Located In:	Corner Code #
			Solon Twp.
1. Public Land Survey		T10N R 11W	H-8
		T___ R___	
		T___ R___	
		T___ R___	
2. Property Controlling	S___	T___ R___	
in Section	S___	T___ R___	
3. Miscellaneous	S___	T___ R___	
Property in Sec.	S___	T___ R___	

4. Lot No. _____, Recorded Plat _____
5. Private Claims _____

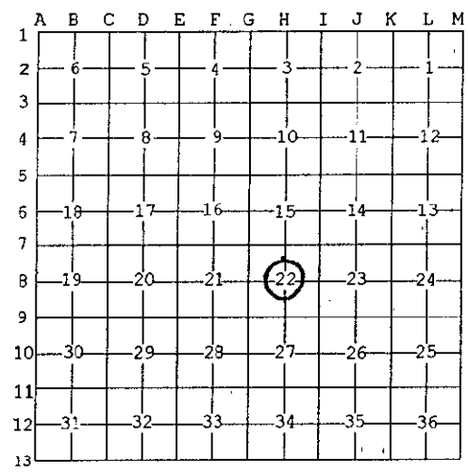

I, Kirk Breitels, in a field survey on Aug. 11, 19 99 do hereby state that under requirements of P.A. 74, Michigan P.A. of 1970, the corner points mentioned in lines 1 and 2 above were in conformance with regulations and rules therefore as required in the current manual of survey instructions of the United States Department of the Interior, Bureau of Land Management or by a decree of a Court of Law and /or that the corner points mentioned in lines 3, 4 and 5 above were in conformance with the rules of the Michigan Board of Land Surveyors or by a Decree of a Court of Law; established, re-established, monumented, recovered, found as expressed below:

NOTE: **Not more than 2 corners, all in the same town and range, may be recorded on this certificate.**

P.A. 345 1990 KENT COUNTY
PLAT APPROVED 8/26/99
CHAIRMAN

A. Description of original monument and accessories and/or subsequent restoration:

H-8	1837	GLO	Not Set
	1901	Williams & Works	Found Iron Bar at intersection of 1/4 lines
	1974	LCRC #587 Spicer	Found 2" Iron

16" Ash S50°W 35.55' 34" Maple N10°E 33.75' 14" Maple S05°W 83.64'

B. Description of corner evidence found and/or method applied in restoring or reestablishing corner:

H-8 Found 2" Iron Bar - with brick around - per remaining witness:
Nail E. side dead 30" Maple N10°E 33.64'

Said 2" Iron Bar is 1.5' S. and 2.0' W. from intersection of 1/4 lines and has been used in surveys by Williams & Works, All Points, Hackbardt, and Roosien.

The 2" Iron Bar is accepted by me and is generally accepted by professional surveyors as the best available evidence of the position of the corner.

C. Description of monument for corner and accessories established to perpetuate locating the position of the corner:

H-8 Set Standard Kent County Monument in place of the 2" Iron Bar

Nail & KC Remon. tag NW side dead 20" Elm	S60°W	61.21'
Nail & KC Remon. tag E. side P. Pole	S30°W	154.79'
Nail & KC Remon. tag W. side 15" Oak	S15°E	65.04'
Nail & KC Remon. tag N. side 10" Maple	S75°E	75.03'
SW corner garage foundation	N40°E	132.85'
Nail E. side dead 30" Maple	N10°E	33.64'
C/L E-W gravel road is North 4' ±		

STATE OF MICHIGAN
KIRK BREITELS
LAND SURVEYOR
NO 30077
LICENSED LAND SURVEYOR

Signed by _____ Date 10/28/99
Surveyor's Michigan License No. 30077

FORM APPROVED BY MICHIGAN STATE BOARD OF PROFESSIONAL SURVEYORS, JAN. 28, 1971
REVISED MAY 14, 1975
REVISED JAN., 1983
REVISED OCT., 1995