

\$7.00
\$2.00

MAY 28 2000

KENT COUNTY REMONUMENTATION

SECTION

LAND CORNER RECORDATION CERTIFICATE
Filing Requirement of Act 74, Mich. P.A. 1970

For corners in

KENT COUNTY

(County)

Located In:

Corner Code #

1. Public Land Survey

T10N R 11W

Solon Twp.
H-9

T R

T R

T R

T R

2. Property Controlling in Section

S T R

S T R

3. Miscellaneous Property in Sec.

S T R

S T R

1999 MAR 24 AM 8:06
STATE OF MICHIGAN
COUNTY OF KENT
RECEIVED FOR RECORD

REG. OF DEEDS


11088

Register of Deeds Stamp & File Number

4. Lot No. _____, Recorded Plat _____
5. Private Claims _____

I, Kirk Breitels, in a field survey on Jan. 18, 1999 do hereby state that under requirements of P.A. 74, Michigan P.A. of 1970, the corner points mentioned in lines 1 and 2 above were in conformance with regulations and rules therefore as required in the current manual of survey instructions of the United States Department of the Interior, Bureau of Land Management or by a decree of a Court of Law and/or that the corner points mentioned in lines 3, 4 and 5 above were in conformance with the rules of the Michigan Board of Land Surveyors or by a Decree of a Court of Law; established, re-established, monumented, recovered, found as expressed below:

NOTE: Not more than 2 corners, all in the same town and range, may be recorded on this certificate.

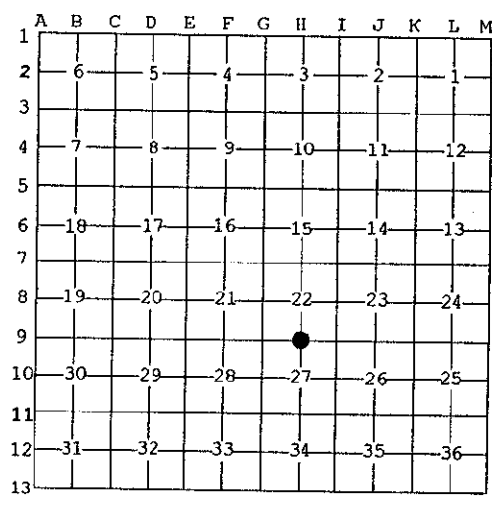

A. Description of original monument and accessories and/or subsequent restoration:

H-9 1837	GLO	Cathcart	Set Post
1954	Kent Co. Wits		Mon. Box
1973	LCRC #374	Bonnema	1/2" Iron in Mon. Box
1973	LCRC #458	VanKooten	1/2" Iron in Mon. Box
1981	LCRC #2132	Jonker	Set Kent County Monument in Mon. Box
1990	LCRC #5607	Marschall	Kent County Monument in Mon. Box

P.A. 345 1990 KENT COUNTY
PEER APPROVED 2/25/99
CHAIRMAN *[Signature]*

The position of this corner was previously approved by the Kent County Remonumentation Peer Group, monumented by Robert J. Jonker on 9-25-81 and was recorded per LCRC #2132.

B. Description of corner evidence found and/or method applied in restoring or reestablishing corner:

H-9 Found Kent County Monument (Harrison) per witnesses from above LCRC as set by Robert J. Jonker in place of the 1/2" Iron he found inside a Mon. Box. Said Iron checks with Kent Co. Wits. and LCRC's #374 & #458.

LCRC #2132	Nail & Remon. tag 6" Poplar	N65°E 113.38'	LCRC #5607	Nail & Remon. tag 28" Cherry	N02°W 78.08'
	Nail & Remon. tag 4" Elm	S75°E 152.06'		Nail & Remon. tag 8" Box Elder	S80°W 214.14'
	Nail & Remon. tag 24" Cherry	N02°E 78.13'		Nail & Remon. tag Face 3" steel post	S05°E 32.60'
	C/L 3" steel cor. fc. post	S03°W 32.74'		Nail & Remon. tag 14" Elm	S75°E 152.09'
	In line tree line South ±				
	On C/L E-W pavement				

The selected location is accepted by me and is generally accepted by professional surveyors as the best available evidence of the position of the original corner.

C. Description of monument for corner and accessories established to perpetuate locating the position of the corner:

II-9 Standard Kent County Monument in Mon. Box					
Nail & KC Remon. tag W. side 32" Cherry	N02°W	78.60'			
Nail & KC Remon. tag NW side Tw. 15" Poplar	N60°E	53.62'			
Nail & KC Remon. tag N. side 16" elm	S75°E	152.07'			
Face of 3" steel fence corner post	S05°E	32.65'			
Nail & KC Remon. tag N. side 10" Elm	S85°W	204.65'			
On C/L E-W pavement ±					
On tree line to N-S ±					



Signed by *[Signature]*
Surveyor's Michigan License No. 30077

Date 2/25/99