



\$7.00
\$2.00

JAY 28 2000

KENT COUNTY REMONUMENTATION

SECTION

LAND CORNER RECORDATION CERTIFICATE Filing Requirement of Act 74, Mich. P.A. 1970

For corners in

KENT COUNTY
(County)

Located in:

Corner Code #

1. Public Land Survey

T 10 N R 11 W
T _____ R _____
T _____ R _____
T _____ R _____

Solon Twp.
I-3

2. Property Controlling in Section

S _____ T _____ R _____
S _____ T _____ R _____
S _____ T _____ R _____
S _____ T _____ R _____

3. Miscellaneous Property in Sec.

4. Lot No. _____, Recorded Plat _____
5. Private Claims _____

STATE OF MICHIGAN
COUNTY OF KENT
RECEIVED FOR RECORD


1999 MAR 24 AM 8:00

REG. OF DEEDS

11091

Register of Deeds Stamp & File Number

I, Kirk Breitels, in a field survey on Jan. 14, 19 99 do hereby state that under requirements of P.A. 74, Michigan P.A. of 1970, the corner points mentioned in lines 1 and 2 above were in conformance with regulations and rules therefore as required in the current manual of survey instructions of the United States Department of the Interior, Bureau of Land Management or by a decree of a Court of Law and/or that the corner points mentioned in lines 3, 4 and 5 above were in conformance with the rules of the Michigan Board of Land Surveyors or by a Decree of a Court of Law; established, re-established, monumented, recovered, found as expressed below:

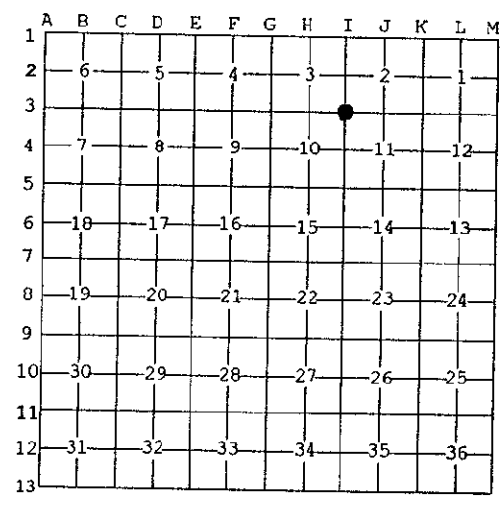

NOTE: Not more than 2 corners, all in the same town and range, may be recorded on this certificate.

A. Description of original monument and accessories and/or subsequent restoration:

I-3	1837	GLO	Cathcart	Set Post
	1966	Kent Co. Wits		Iron & Stone
	1984	LCRC #3803	Bueche	Set Kent County Monument
	1990	LCRC #5610	Marschall	Kent County Monument
	1993	LCRC #6811	W. Glaza	Reset Kent County Monument after construction

P.A. 345 1990 KENT COUNTY
PEER APPROVED 2/25/99
CHAIRMAN Harry Huber

The position of this corner was previously approved by the Kent County Remonumentation Peer Group, monumented by John C. Bueche on 4-21-84 and was recorded per LCRC #3803.

B. Description of corner evidence found and/or method applied in restoring or reestablishing corner:

I-3 Found Kent County Monument (Harrison) per witnesses from above LCRC as set by John C. Bueche in place of the Iron he found. Said Iron (did not find Stone) checks with Kent Co. Wits. and information of others.

LCRC #3803	LCRC #5610	LCRC #6811
10" Poplar S55°W 29.32'	6" Maple N75°W 35.41'	16" Oak S48°W 61.34'
8" Maple N80°W 35.43'	12" Oak N40°W 41.08'	12" Oak S85°E 38.45'
12" Oak N35°W 41.14'	6" Oak N60°E 40.62'	24" Oak N26°W 75.94'
6" Maple N60°E 40.63'	16" Oak S50°E 40.17'	30" Oak S27°E 101.88'
18" Oak S85°E 31.82'		C/L Simmons Ave. East 1'
14" Oak S50°E 40.19'		

The selected location is accepted by me and is generally accepted by professional surveyors as the best available evidence of the position of the original corner.

C. Description of monument for corner and accessories established to perpetuate locating the position of the corner:

I-3 Standard Kent County Monument

Nail & KC Remon. tag SE side 18" Oak	S48°W	61.40'
Nail & KC Remon. tag N. side 12" Oak	S85°E	38.58' - Nail 5' high
Nail & KC Remon. tag E. side 26" Oak	N26°W	75.96'
Nail & KC Remon. tag NE side 32" Oak	S27°E	101.92'
C/L Simmons Ave. (asphalt) is East 1' ±		



Signed by Kirk Breitels
Surveyor's Michigan License No. 30077

Date 2/25/99