

MAY 22 1999

KENT COUNTY REMONUMENTATION

LAND CORNER RECORDATION CERTIFICATE Filing Requirement of Act 74, Mich. P.A. 1970

\$7.00
\$2.00

SECTION

STATE OF MICHIGAN
COUNTY OF KENT
RECEIVED FOR RECORD
1999 MAR 26 AM 8:00

REG. OF DEEDS


11095
Register of Deeds Stamp & File Number

For corners in
KENT COUNTY
(County)

Located In: Solon Twp.
Corner Code # I-9

1. Public Land Survey	T <u>10</u> N <u>R</u> 11 W	<u>I-9</u>
	T <u> </u> R <u> </u>	<u> </u>
	T <u> </u> R <u> </u>	<u> </u>
	T <u> </u> R <u> </u>	<u> </u>
2. Property Controlling in Section	S <u> </u> T <u> </u> R <u> </u>	<u> </u>
	S <u> </u> T <u> </u> R <u> </u>	<u> </u>
3. Miscellaneous Property in Sec.	S <u> </u> T <u> </u> R <u> </u>	<u> </u>
	S <u> </u> T <u> </u> R <u> </u>	<u> </u>

4. Lot No. _____, Recorded Plat _____
5. Private Claims _____

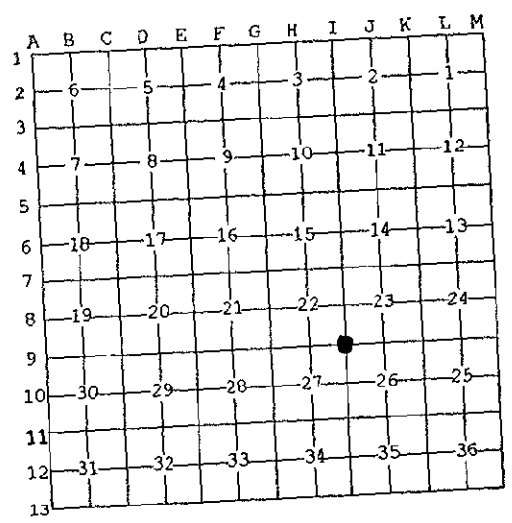

I, Kirk Breitels, in a field survey on Jan. 12, 1999 do hereby state that under requirements of P.A. 74, Michigan P.A. of 1970, the corner points mentioned in lines 1 and 2 above were in conformance with regulations and rules therefore as required in the current manual of survey instructions of the United States Department of the Interior, Bureau of Land Management or by a decree of a Court of Law and/or that the corner points mentioned in lines 3, 4 and 5 above were in conformance with the rules of the Michigan Board of Land Surveyors or by a Decree of a Court of Law; established, re-established, monumented, recovered, found as expressed below:

NOTE: Not more than 2 corners, all in the same town and range, may be recorded on this certificate.

- A. Description of original monument and accessories and/or subsequent restoration:
- | | | | | |
|-----|------|---------------|-----------|--------------------------------------|
| I-9 | 1837 | GLO | Cathcart | Set Post |
| | | Kent Co. Wits | | Stone |
| | 1973 | LCRC #374 | Bonemma | "T" Iron |
| | 1973 | LCRC #458 | VanKooten | "T" Iron |
| | 1981 | LCRC #2121 | Jonker | Set Kent County Monument in Mon. Box |
| | 1990 | LCRC #5612 | Marschall | Kent County Monument |

P.A. 345 1990 KENT COUNTY
PEER APPROVED 2/25/99
CHAIRMAN Harrison

The position of this corner was previously approved by the Kent County Remonumentation Peer Group, monumented by Robert J. Jonker on 9-25-81 and was recorded per LCRC #2121.

- B. Description of corner evidence found and/or method applied in restoring or reestablishing corner:
- I-9 Found Kent County Monument (Harrison) per witnesses from above LCRC as set by Robert J. Jonker in place of the "T" Iron he found inside a Mon. Box. Said "T" Iron checks with LCRC's #374 & #458. No Kent Co. Wits. remain.
- | | | | | |
|---------------------------------------|-------|--------|-----------------------------------|---------------|
| LCRC #2121 | | | | LCRC #5612 |
| Nail & Remon. tag P. Pole | S42°W | 56.43' | "X" on N. end 15" conc. culv. | N75°E 79.84' |
| "X" on N. end road culvert | N75°E | 79.75' | "X" on S. end 15" conc. culv. | N75°E 79.81'? |
| "X" on S. end road culvert | S72°E | 78.85' | Nail & Remon. tag P. P. | S40°W 56.36' |
| C/L street sign | N33°W | 39.3' | Nail & Remon. tag 6"-12" Twin Ash | S65°W 74.13' |
| On C/L B.T., in line C/L gravel to N. | | | | |

The selected location is accepted by me and is generally accepted by professional surveyors as the best available evidence of the position of the original corner.

- C. Description of monument for corner and accessories established to perpetuate locating the position of the corner:

- I-9 Standard Kent County Monument
- | | | |
|--|-------|--------|
| "X" cut on N. end concrete culvert | N75°E | 79.84' |
| Cut new "X" on S. end concrete culvert | S75°E | 78.70' |
| Nail & KC Remon. tag SE side P. Pole | S40°W | 56.36' |
| Nail & KC Remon. tag SE side Twin 10" Ash | S50°W | 60.52' |
| Nail & KC Remon. tag S. side 8"-15" Twin Ash | S65°W | 74.02' |
| On C/L roads E-W & N ± | | |



Signed by Kirk Breitels
Surveyor's Michigan License No. 30077

Date 2/25/99