

**LAND CORNER RECORDATION CERTIFICATE**  
**Filing Requirement of Act 74, Mich. P.A. 1970**

STATE OF MICHIGAN  
 REC'D  
 93 AUG 21 1993

For corners in

Kent (County) Located In: \_\_\_\_\_ Corner Code // \_\_\_\_\_

1. Public Land Survey T 10N R 11W J-4  
 T \_\_\_\_\_ R \_\_\_\_\_  
 T \_\_\_\_\_ R \_\_\_\_\_  
 T \_\_\_\_\_ R \_\_\_\_\_

2. Property Controlling S \_\_\_\_\_ T \_\_\_\_\_ R \_\_\_\_\_  
 in Section S \_\_\_\_\_ T \_\_\_\_\_ R \_\_\_\_\_

3. Miscellaneous S \_\_\_\_\_ T \_\_\_\_\_ R \_\_\_\_\_  
 Property in Sec. S \_\_\_\_\_ T \_\_\_\_\_ R \_\_\_\_\_

4. Lot No. \_\_\_\_\_, Recorded Plat \_\_\_\_\_

5. Private Claims \_\_\_\_\_

*Log #1*

*6813*

**6813**

Register of Deeds Stamp & File Number

I, Wallace E. Glaza, in a field survey on August 12, 19 93

do hereby certify that under requirements of P.A. 74, Michigan P.A. of 1970, the corner points mentioned in lines 1 and 2 above were in conformance with regulations and rules therefore as required in the current manual of survey instructions of the United States Department of the Interior, Bureau of Land Management or by a decree of a Court of Law and/or that the corner points mentioned in lines 3, 4 and 5 above were in conformance with the rules of the Michigan Board of Land Surveyors or by a Decree of a Court of Law; established, re-established, monumented, re-monumented, recovered, found as expressed below:

**NOTE: Not more than 4 corners, all in the same town and range, may be recorded on this certificate.**

	A	B	C	D	E	F	G	H	I	J	K	L
2	6		5		4			3		2		
3												
4	7		8		9			10		12		
5												
6	18		17		16			15		14		13
7												
8	19		20		21			22		23		24
9												
10	30		29		28			27		26		25
11												
12	31		32		33			34		35		36
13												

A. Description of original monument and accessories and/or subsequent restoration:

LCRC No. 4494 (MUK)

- Set sq spike in s side maple E 101.35'
- Set sq spike in S'ly side 28" Oak W-NW 6.07'
- Face of 12" conc end fence post W+NW 14.55'
- Set sq spike in SW side 12" Oak NW 35.35'
- 3'± South of East-West tree row
- Fence to North W 14'
- Fence to South E 98'

B. Description of corner evidence found and/or method applied in restoring or reestablishing corner:

J-4 (Center of Section 11, T10N, R11W, Solon Township, Kent County, Michigan.)

Found MUK iron. Iron is 0.33' East and 0.14' South of intersection of 1/4 lines. Accepted iron as center of Section 11.


Replace MUK iron with standard 4" x 30" harrison Monument.

- South 1/4 corner to center - 2636.97'
- West 1/4 corner to center - 2694.37'
- North 1/4 corner to center - 2623.13'
- East 1/4 corner to center - 2693.25'

C. Description of monument for corner and accessories established to perpetuate locating the position of the corner:

J-4 (Standard 4" x 30" Harrison Monument)

- 1) nail and tag in S side 12" Elm N80°W 20.25'
- 2) Nail and tag in NE side 36" Oak N35°W 6.07'
- 3) Nail and tag in S side 40" Double Oak N90°E 101.33'
- 4) Nail and tag in NE side 16" Oak N25°W 35.58'
- 5) Centerline 1' dia conc fence post N70°W 15.03'

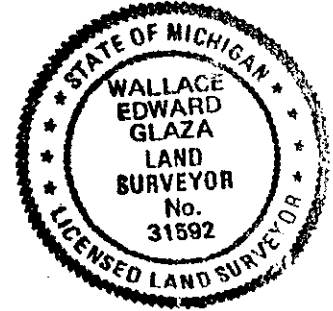

Signed by Wallace E. Glaza Date 8-17-93  
 Glaza and Associates, Inc. 31592  
 Surveyor's Michigan License No. \_\_\_\_\_