SURVEY & MAPPING
MAY 22 2000
SECTION

$7.00
$2.00

KENT COUNTY REMONUMENTATION

LAND CORNER RECORDATION CERTIFICATE
Filing Requirement of Act 74, Mich. P.A. 1970

STATE OF MICHIGAN
COUNTY OF KENT
RECEIVED FOR RECORD
1999 NOV -4 AM 8:35
REG. OF DEEDS

11475
Register of Deeds Stamp & File Number

For corners in

KENT COUNTY
(County)

	Located In:		Corner Code #
			Solon Twp.
1. Public Land Survey		T10N R 11W	L-1
		T___ R___	
		T___ R___	
		T___ R___	
2. Property Controlling	S___	T___ R___	
in Section	S___	T___ R___	
3. Miscellaneous	S___	T___ R___	
Property in Sec.	S___	T___ R___	

4. Lot No. _____ , Recorded Plat _____
5. Private Claims _____

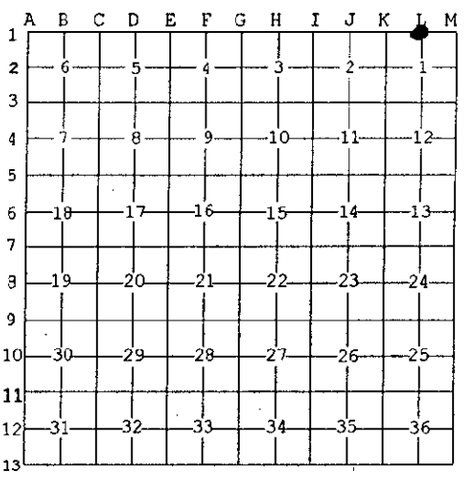

I, Kirk Breitels, in a field survey on Aug. 27, 19 99 do hereby state that under requirements of P.A. 74, Michigan P.A. of 1970, the corner points mentioned in lines 1 and 2 above were in conformance with regulations and rules therefore as required in the current manual of survey instructions of the United States Department of the Interior, Bureau of Land Management or by a decree of a Court of Law and /or that the corner points mentioned in lines 3, 4 and 5 above were in conformance with the rules of the Michigan Board of Land Surveyors or by a Decree of a Court of Law; established, re-established, monumented, recovered, found as expressed below:

NOTE: Not more than 2 corners, all in the same town and range, may be recorded on this certificate.

P.A. 345 1990 KENT COUNTY
PEER APPROVED 9/23/99
CHAIRMAN Gary Hilber

A. Description of original monument and accessories and/or subsequent restoration:

L-1	1837	GLO	Cathcart	Not Set
	1937	Kent Co. Wits		1" Iron
	1981	LCRC #3564	VanKooten	1" Solid Iron
	1985	LCRC #4389	Ochs	Set Kent County Monument on Twp. line
	1990	LCRC #5620	Marschall	Kent County Monument

The position of this corner was previously approved by the Kent County Remonumentation Peer Group, monumented by Norman L. Ochs on 10-23-85 and was recorded per LCRC #4389.

B. Description of corner evidence found and/or method applied in restoring or reestablishing corner:

L-1 Found BROKEN Kent County Monument (Harrison)and REPLACED in Mon. Box per witnesses from above LCRC as set on Twp. Line by Norman L. Ochs in place of the 1" Solid Iron he found. Said Iron checks with LCRC #3564 & Kent Co. Wits.

LCRC #[redacted] 4389			LCRC #5620		
PK Nail P. Pole	SSW	38.00'	"X" cut on culv.	S55°E	35.53'
"X" on W. end culv.	SE	35.52'	"X" cut on culv.	S70°W	73.74'
"X" on E. end culv.	WSW	79.79'	Nail & Remon. tag P. Pole	S10°W	37.96'
E. end culv.	S45°E	56.96'	Nail & Remon. tag 10" Maple	S30°E	70.69'
SE cor. Sec. 36 Ensley Twp. is West 216.11'			C/L 2' ± South		

The selected location is accepted by me and is generally accepted by professional surveyors as the best available evidence of the position of the corner.

C. Description of monument for corner and accessories established to perpetuate locating the position of the corner:

L-1 Standard Kent County Monument in Mon. Box

"X" cut on top concrete culvert	S55°E	35.52'
"X" cut on top concrete culvert	S70°W	73.77'
Nail & KC Remon. tag E. side P. Pole	S10°W	37.93'
Nail & KC Remon. tag S. side P. Pole	S65°E	132.42'
Newaygo Co. Mon. (M-13, Ensley Twp.)	West	216.21'

STATE OF MICHIGAN
KIRK BREITELS
LAND SURVEYOR
NO
30077
LICENSED LAND SURVEYOR

Signed by Kirk Breitels
Date 10/28/99
Surveyor's Michigan License No. 30077

FORM APPROVED BY MICHIGAN STATE BOARD OF PROFESSIONAL SURVEYORS, JAN. 28, 1971
REVISED MAY 14,1975
REVISED JAN., 1983
REVISED OCT., 1995