

NOV 22 2000

\$7.00  
\$2.00

SECTION

KENT COUNTY REMONUMENTATION

LAND CORNER RECORDATION CERTIFICATE  
Filing Requirement of Act 74, Mich. P.A. 1970

RECEIVED FOR RECORD  
1999 DEC 15 AM 8:56

REG. OF DEEDS

*[Handwritten Signature]*

For corners in

KENT COUNTY (County)	Located In:	Corner Code #
1. Public Land Survey	T 10NR 11W	Solon Twp. L-2
	T ___ R ___	_____
	T ___ R ___	_____
	T ___ R ___	_____
2. Property Controlling in Section	S ___ T ___ R ___	_____
	S ___ T ___ R ___	_____
3. Miscellaneous Property in Sec.	S ___ T ___ R ___	_____
	S ___ T ___ R ___	_____

11594

Register of Deeds Stamp & File Number

4. Lot No. \_\_\_\_\_, Recorded Plat \_\_\_\_\_  
5. Private Claims \_\_\_\_\_

I, Kirk Breitels, in a field survey on Aug. 30, 1999 do hereby state that under requirements of P.A. 74, Michigan P.A. of 1970, the corner points mentioned in lines 1 and 2 above were in conformance with regulations and rules therefore as required in the current manual of survey instructions of the United States Department of the Interior, Bureau of Land Management or by a decree of a Court of Law and/or that the corner points mentioned in lines 3, 4 and 5 above were in conformance with the rules of the Michigan Board of Land Surveyors or by a Decree of a Court of Law; established, re-established, monumented, recovered, found as expressed below:

NOTE: Not more than 2 corners, all in the same town and range, may be recorded on this certificate.

	A	B	C	D	E	F	G	H	I	J	K	L	M
1													
2	6		5		4		3		2			1	
3													
4	7		8		9		10		11		12		
5													
6	18		17		16		15		14		13		
7													
8	19		20		21		22		23		24		
9													
10	30		29		28		27		26		25		
11													
12	31		32		33		34		35		36		
13													

A. Description of original monument and accessories and/or subsequent restoration:

L-2 1837	GLO	Not Set
	Williams & Works	No information
	Kent Co. Wits	No information
1981	LCRC #3564 VanKooten	Set Iron at intersection of 1/4 lines
	Sq. Spike W. side 8" Maple South	6.0' Sq. Spike SE side 12" Pine NE 12.0'
	Sq. Spike SW side 6" Pine SW	14.9' Sq. Spike NW side 10" Lean. Pine NW 16.0'

P.A. 345 1990 KENT COUNTY  
PEER APPROVED 9/23/99  
CHAIRMAN Harry Kube

B. Description of corner evidence found and/or method applied in restoring or reestablishing corner:

L-2 Found Capped Rerod (MVK) per the remaining witnesses. Did not measure to Capped Rerod - location is surrounded by a minimum of 1000' of swamp, making measurement somewhat unreliable.


Measurements shown on MVK survey agree with computed Intersection of 1/4 lines by 0.1' and 00°00'15". Computed Intersection of 1/4 lines was also used in surveys by Hackbardt.

The Intersection of 1/4 lines is accepted by me and is generally accepted by professional surveyors as the best available evidence of the position of the corner.

C. Description of monument for corner and accessories established to perpetuate locating the position of the corner:

L-2 NO MONUMENT SET AT THIS CORNER - CORNER FALLS IN SWAMP.

See LCRC # \_\_\_\_\_ and LCRC # \_\_\_\_\_ for location of witnesses monuments.

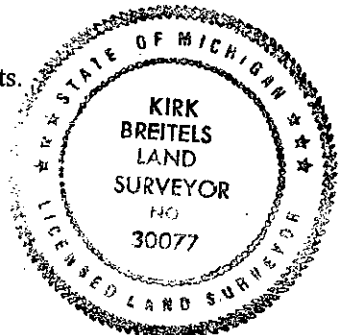

Signed by *[Signature]*  
Surveyor's Michigan License No. 30077

Date 12/6/99