

MAY 22 2000

\$7.00
\$2.00

KENT COUNTY REMONUMENTATION

SECTION

LAND CORNER RECORDATION CERTIFICATE
Filing Requirement of Act 74, Mich. P.A. 1970

For corners in

KENT COUNTY

(County)

Located In:

Corner Code #

Solon Twp.

1. Public Land Survey

T 10N R 11W

L-10

T R

T R

T R

T R

2. Property Controlling in Section

S T R

S T R

3. Miscellaneous Property in Sec.

S T R

S T R

REG. OF DEEDS

[Signature]

STATE OF MICHIGAN
COUNTY OF KENT
RECEIVED FOR RECORD
1999 NOV - 4 AM 8:36

11480

Register of Deeds Stamp & File Number

4. Lot No. _____, Recorded Plat _____
5. Private Claims _____

I, Kirk Breitels, in a field survey on Aug. 12, 1999 do hereby state that under requirements of P.A. 74, Michigan P.A. of 1970, the corner points mentioned in lines 1 and 2 above were in conformance with regulations and rules therefore as required in the current manual of survey instructions of the United States Department of the Interior, Bureau of Land Management or by a decree of a Court of Law and /or that the corner points mentioned in lines 3, 4 and 5 above were in conformance with the rules of the Michigan Board of Land Surveyors or by a Decree of a Court of Law; established, re-established, monumented, recovered, found as expressed below:

NOTE: Not more than 2 corners, all in the same town and range, may be recorded on this certificate.

A	B	C	D	E	F	G	H	I	J	K	L	M
1												
2	6		5		4		3		2		1	
3												
4	7		8		9		10		11		12	
5												
6	18		17		16		15		14		13	
7												
8	19		20		21		22		23		24	
9												
10	30		29		28		27		26		25	
11												
12	31		32		33		34		35		36	
13												

A. Description of original monument and accessories and/or subsequent restoration:

- L-10 1837 GLO Not Set
1945-66 Williams & Works Set Spike on E-W 1/4 line and in line with N-S fence
NE cor. hdwll. S 13.08' SE cor. hdwll. N 11.22' 10" Oak N 36.60' 14" Elm WNW 109.95'
- 1973 LCRC #561 VanKooten Found 3/4" Iron
SW cor. ret. wall NNE 122.72' NW cor. bldg. SSE 112.25' NE cor. hdwll. N 12.15'
SE cor. hdwll. S 14.06' Top of hydr. ENE 57.96'

P.A. 345 1990 KENT COUNTY
PEER APPROVED 8/26/99
CHAIRMAN [Signature]

B. Description of corner evidence found and/or method applied in restoring or reestablishing corner:


- L-10 Found Capped Rerod (Hackbart) in newly constructed road per remaining witnesses:
Spike W. side 36" Oak N00°W 37.00' SW cor. ret. wall N35°E 122.62'
NW bldg. cor. siding S10°E 112.09'
Top of hydrant N60°E 57.92'

Said Capped Rerod is 0.5' N. and 0.6' W. from intersection of 1/4 lines and agrees with measurements of others.

The Capped Rerod (Hackbart) is accepted by me and is generally accepted by professional surveyors as the best available evidence of the position of the corner.

C. Description of monument for corner and accessories established to perpetuate locating the position of the corner:

- L-10 Set Standard Kent County Monument in Mon. Box in place of the Capped Rerod (Hackbart).
SW corner concrete retaining wall N35°E 122.62'
Top bolt of fire hydrant N60°E 57.92'
Spike in W. side 36" Oak N00°W 37.00'
Cut "X" top of W'ly concrete culvert S65°W 38.63'
NW corner building - siding S10°E 112.09'
Nail & KC Remon. tag S. side 30" Willow S50°E 85.71'

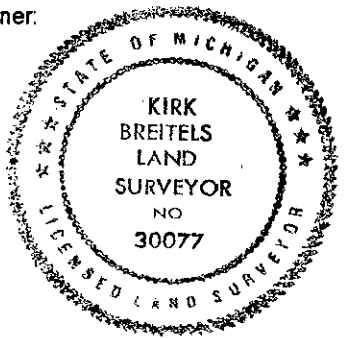

Signed by [Signature]
Surveyor's Michigan License No. 30077

Date 10/20/99