$7.00
$2.00

MAY 22 2000

SECTION

KENT COUNTY REMONUMENTATION

LAND CORNER RECORDATION CERTIFICATE
Filing Requirement of Act 74, Mich. P.A. 1970

For corners in

KENT COUNTY
(County)

Located In: Corner Code #

STATE OF MICHIGAN
COUNTY OF KENT
RECEIVED FOR RECORD
1999 MAR 24 AM 8:00
REG. OF DEEDS

11111
Register of Deeds Stamp & File Number

1. Public Land Survey		T 10N	R 11W	M-2 Solon Twp.
		T___	R___	Common
		~~T 10N~~	~~R 10W~~	~~A-2 Nelson Twp.~~
		T___	R___	
2. Property Controlling	S___	T___	R___	
in Section	S___	T___	R___	
3. Miscellaneous	S___	T___	R___	
Property in Sec.	S___	T___	R___	

4. Lot No. _____ , Recorded Plat _____
5. Private Claims _____

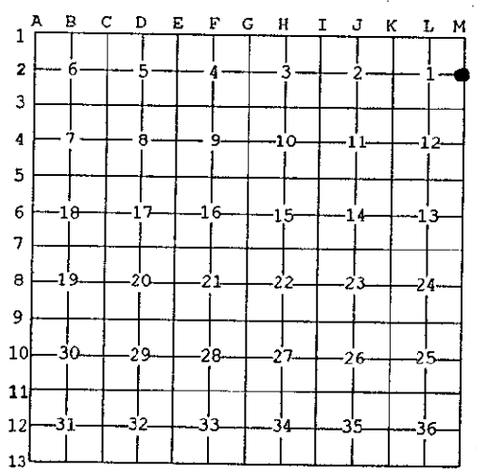

I, Kirk Breitels, in a field survey on Feb. 9, 19 99 do hereby state that under requirements of P.A. 74, Michigan P.A. of 1970, the corner points mentioned in lines 1 and 2 above were in conformance with regulations and rules therefore as required in the current manual of survey instructions of the United States Department of the Interior, Bureau of Land Management or by a decree of a Court of Law and /or that the corner points mentioned in lines 3, 4 and 5 above were in conformance with the rules of the Michigan Board of Land Surveyors or by a Decree of a Court of Law; established, re-established, monumented, recovered, found as expressed below:

NOTE: Not more than 2 corners, all in the same town and range, may be recorded on this certificate.

P.A. 345 1930 KENT COUNTY
PEER APPROVED 2/25/99
CHAIRMAN Harry Haberer

A. Description of original monument and accessories and/or subsequent restoration:

M-2	1837	GLO	Brookfield	Set Post
	1901	Williams & Works		Stake & Crockery
	1961	Kent Co. Wits		2" Iron
	1981	LCRC #3564	VanKooten	Iron in Mon. Box
	1983	LCRC #3610	Hackbardt	Iron in Mon. Box
	1992	LCRC #6596	Bueche	Set Kent County Monument in Mon. Box

The position of this corner was previously approved by the Kent County Remonumentation Peer Group, monumented by John C. Bueche on 10-12-96 and was recorded per LCRC #6596.

B. Description of corner evidence found and/or method applied in restoring or reestablishing corner:

M-2 Found Kent County Monument (Harrison) per witnesses from above LCRC as set by John C. Bueche in place of the Iron he found in a Mon. Box. Said Iron checks with LCRC's #3564 & #3610. No Kent Co. Wits. remain.
LCRC #6596

Square Spike S. side P. Pole	N70°E	106.99'
Nail & Remon. tag in curb joint	N45°E	41.43'
SE corner concrete porch	N60°W	111.84'
NW corner house foundation	S60°E	126.17'
"X" on curb	S25°E	50.18'

On C/L bit. N-S and on C/L gravel East

The selected location is accepted by me and is generally accepted by professional surveyors as the best available evidence of the position of the original corner.

C. Description of monument for corner and accessories established to perpetuate locating the position of the corner:

M-2 Standard Kent County Monument in Mon. Box

Square Spike in S. side P. Pole	N70°E	107.05'
Nail & KC Remon. tag in curb joint	N45°E	41.46'
SE corner concrete porch	N60°W	111.78'
NW corner house foundation	S60°E	126.25'
"X" on curb	S25°E	50.18'

On C/L N-S asphalt road and on C/L gravel road East ±

STATE OF MICHIGAN
KIRK BREITELS
LAND SURVEYOR
NO 30077
LICENSED LAND SURVEYOR

Signed by Kirk Breitels
Surveyor's Michigan License No. 30077

Date 2/25/99

FORM APPROVED BY MICHIGAN STATE BOARD OF PROFESSIONAL SURVEYORS, JAN. 28, 1971
REVISED MAY 14,1975
REVISED JAN., 1983
REVISED OCT., 1995