

MAY 28 2000

\$7.00
\$2.00

SECTION

KENT COUNTY REMONUMENTATION

LAND CORNER RECORDATION CERTIFICATE
Filing Requirement of Act 74, Mich. P.A. 1970

STATE OF MICHIGAN
COUNTY CLERK
RECEIVED FOR RECORD
1999 JUL -9 AM 11:20

REG. STAMPS

11248

Register of Deeds Stamp & File Number

For corners in

KENT COUNTY
(County)

Located in:

Corner Code #

- 1. Public Land Survey
T 10N R 11W M-9 Solon
T R Common
~~T 10N R 10W~~ ~~A-9 Nelson~~
T R _____
- 2. Property Controlling
in Section S T R _____
S T R _____
- 3. Miscellaneous
Property in Sec. S T R _____
S T R _____

- 4. Lot No. _____, Recorded Plat _____
- 5. Private Claims _____

I, Kirk Breitels, in a field survey on May 17, 19 99 do hereby state that under requirements of P.A. 74, Michigan P.A. of 1970, the corner points mentioned in lines 1 and 2 above were in conformance with regulations and rules therefore as required in the current manual of survey instructions of the United States Department of the Interior, Bureau of Land Management or by a decree of a Court of Law and /or that the corner points mentioned in lines 3, 4 and 5 above were in conformance with the rules of the Michigan Board of Land Surveyors or by a Decree of a Court of Law; established, re-established, monumented, recovered, found as expressed below:

NOTE: Not more than 2 corners, all in the same town and range, may be recorded on this certificate.

	A	B	C	D	E	F	G	H	I	J	K	L	M
1													
2	6		5		4		3		2		1		
3													
4	7		8		9		10		11		12		
5													
6	18		17		16		15		14		13		
7													
8	19		20		21		22		23		24		
9													
10	30		29		28		27		26		25		
11													
12	31		32		33		34		35		36		
13													

A. Description of original monument and accessories and/or subsequent restoration:

- M-9 1837 GLO Brookfield Set Post
- 1948 Kent Co. Wits Iron in Tile
- 1973 LCRC #489 Spicer 1/2" Iron in Mon. Box
- 1982 LCRC #3124 Merdzinski Set Kent County Monument in Mon. Box
- 1990 LCRC #5597 Marschall Kent County Monument

P.A. 345 1000 KENT COUNTY
PEER APPROVED 6/24/99
CHAIRMAN [Signature]

The position of this corner was previously approved by the Kent County Remonumentation Peer Group, monumented by John A. Merdzinski on 10-18-82 and was recorded per LCRC #3124.

B. Description of corner evidence found and/or method applied in restoring or reestablishing corner:


M-9 Found Kent County Monument (Harrison) per witnesses from above LCRC as set by John A. Merdzinski in place of the 3/4" Iron he found over a 1 1/4" Iron in a Mon. Box. Both check with Kent Co. Wit. and LCRC #489.

- | | | | |
|------------|--|------------|--|
| LCRC #5597 | Nail & Remon. tag 30" Oak S45°E 56.90' | LCRC #5597 | Nail & Remon. tag 1" w. 26"-36" Oak S45°E 56.81' |
| | Nail & Remon. tag 8" Elm N30°E 68.63' | | Nail & Remon. tag 8" Elm N30°E 68.78' |
| | Nail & Remon. tag 16" Cherry S20°W 157.80' | | Nail & Remon. tag 22" Cherry S20°W 157.69' |
| | Top C/L RR Iron fence post S80°E 56.1' | | Top C/L RR Iron fence post S80°E 56.08' |
- C/L blacktop road is 2.5' West of corner
Corner is on fence line to West

The selected location is accepted by me and is generally accepted by professional surveyors as the best available evidence of the position of the original corner.

C. Description of monument for corner and accessories established to perpetuate locating the position of the corner:

- M-9 Standard Kent County Monument
- Nail & KC Remon. tag SW side Tw- 26-36" Oak S45°E 56.86'
- Nail & KC Remon. tag W. side 12" Elm N30°E 68.78'
- Nail & KC Remon. tag E. side 24" Cherry S20°W 157.69'
- Top C/L RR Iron fence post S80°E 56.08'
- Nail & KC Remon. tag S. side P. Pole S90°W 118.22'

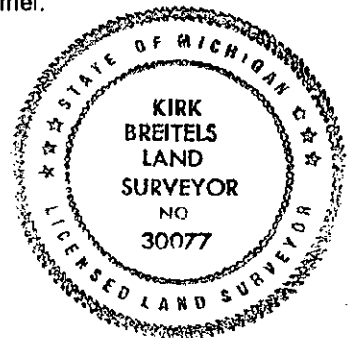

Signed by [Signature]
Surveyor's Michigan License No. 30077

Date 6/24/99