

MAY 22 2000

\$7.00
\$2.00

KENT COUNTY REMONUMENTATION

SECTION

LAND CORNER RECORDATION CERTIFICATE
Filing Requirement of Act 74, Mich. P.A. 1970

Seg 2
other
corner # 6

STATE OF MICHIGAN
COUNTY OF KENT
RECEIVED FOR RECORD
1999 JUL -9 AM 11:19

REG. DEEDS

11236

Register of Deeds Stamp & File Number

For corners in

KENT COUNTY

(County)

Located In:

Corner Code #

1. Public Land Survey

T ___ R ___
T ___ R ___
T ___ R ___
T ___ R ___

2. Property Controlling in Section

S ___ T ___ ION R ___ I W
Wit. Mon. on

3. Miscellaneous Property in Sec.

S ___ T ___ R ___
S ___ T ___ R ___
N-S 1/4 Line

4. Lot No. _____, Recorded Plat _____
5. Private Claims _____

I, Kirk Breitels, in a field survey on June 1, 19 99 do hereby state that under requirements of P.A. 74, Michigan P.A. of 1970, the corner points mentioned in lines 1 and 2 above were in conformance with regulations and rules therefore as required in the current manual of survey instructions of the United States Department of the Interior, Bureau of Land Management or by a decree of a Court of Law and /or that the corner points mentioned in lines 3, 4 and 5 above were in conformance with the rules of the Michigan Board of Land Surveyors or by a Decree of a Court of Law; established, re-established, monumented, recovered, found as expressed below.

NOTE: Not more than 2 corners, all in the same town and range, may be recorded on this certificate.

| | | | | | | | | | | | | |
|----|----|----|----|----|----|----|---|---|---|---|---|---|
| A | B | C | D | E | F | G | H | I | J | K | L | M |
| 1 | | | | | | | | | | | | |
| 2 | 6 | 5 | 4 | 3 | 2 | 1 | | | | | | |
| 3 | | | | | | | | | | | | |
| 4 | 7 | 8 | 9 | 10 | 11 | 12 | | | | | | |
| 5 | | | | | | | | | | | | |
| 6 | 10 | 17 | 16 | 15 | 14 | 13 | | | | | | |
| 7 | | | | | | | | | | | | |
| 8 | 19 | 20 | 21 | 22 | 23 | 24 | | | | | | |
| 9 | | | | | | | | | | | | |
| 10 | 30 | 29 | 28 | 27 | 26 | 25 | | | | | | |
| 11 | | | | | | | | | | | | |
| 12 | 31 | 32 | 33 | 34 | 35 | 36 | | | | | | |
| 13 | | | | | | | | | | | | |

A. Description of original monument and accessories and/or subsequent restoration:

1837 GLO Cathcart Not Set
1993 LCRC #6808 W. Glaza Set Kent Co. Witness Monument on N-S 1/4 Line 2550.34' North of Central 1/4 corner of Sec. 11

The position of this corner was previously approved by the Kent County Remonumentation Peer Group, as monumented by Wallace E. Glaza on 8-17-93 and was recorded per LCRC #6808

B. Description of corner evidence found and/or method applied in restoring or reestablishing corner:


Found Kent Co. Witness Monument per witnesses of above LCRC as set by Wallace C. Glaza.
Nail & KC Remon. tag E. side 10" Elm N00°E 11.54'
Nail & KC Remon. tag NE side 24" Oak S40°E 28.56'
Nail & KC Remon. tag W. side 24" Oak S20°W 61.73'
Nail & KC Remon. tag S. side 8" Elm S90°W 7.20'
Northwest corner house S20°E 99.70'

P.A. 345 1990 KENT COUNTY
PEER APPROVED 6/24/99
CHAIRMAN *Henry Huber*

The above location is accepted by me and is generally accepted by professional surveyors as the best available evidence of the position of the Witness Corner.

C. Description of monument for corner and accessories established to perpetuate locating the position of the corner:

Kent County Witness Monument
Nail & KC Remon. tag E. side 12" Oak N00°E 11.56'
Nail & KC Remon. tag NE side 26" Oak S40°E 28.56'
Nail & KC Remon. tag W. side 26" Oak S20°W 61.70'
Nail & KC Remon. tag S. side 12" Elm S90°W 7.23'
Northwest corner house foundation S20°E 99.77'

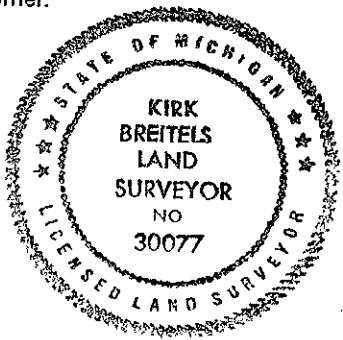

Signed by *Kirk Breitels*
Surveyor's Michigan License No. 30077

Date 6/24/99