


GOVERNMENT SURVEY CORNER NUMBERING CODE DIAGRAM

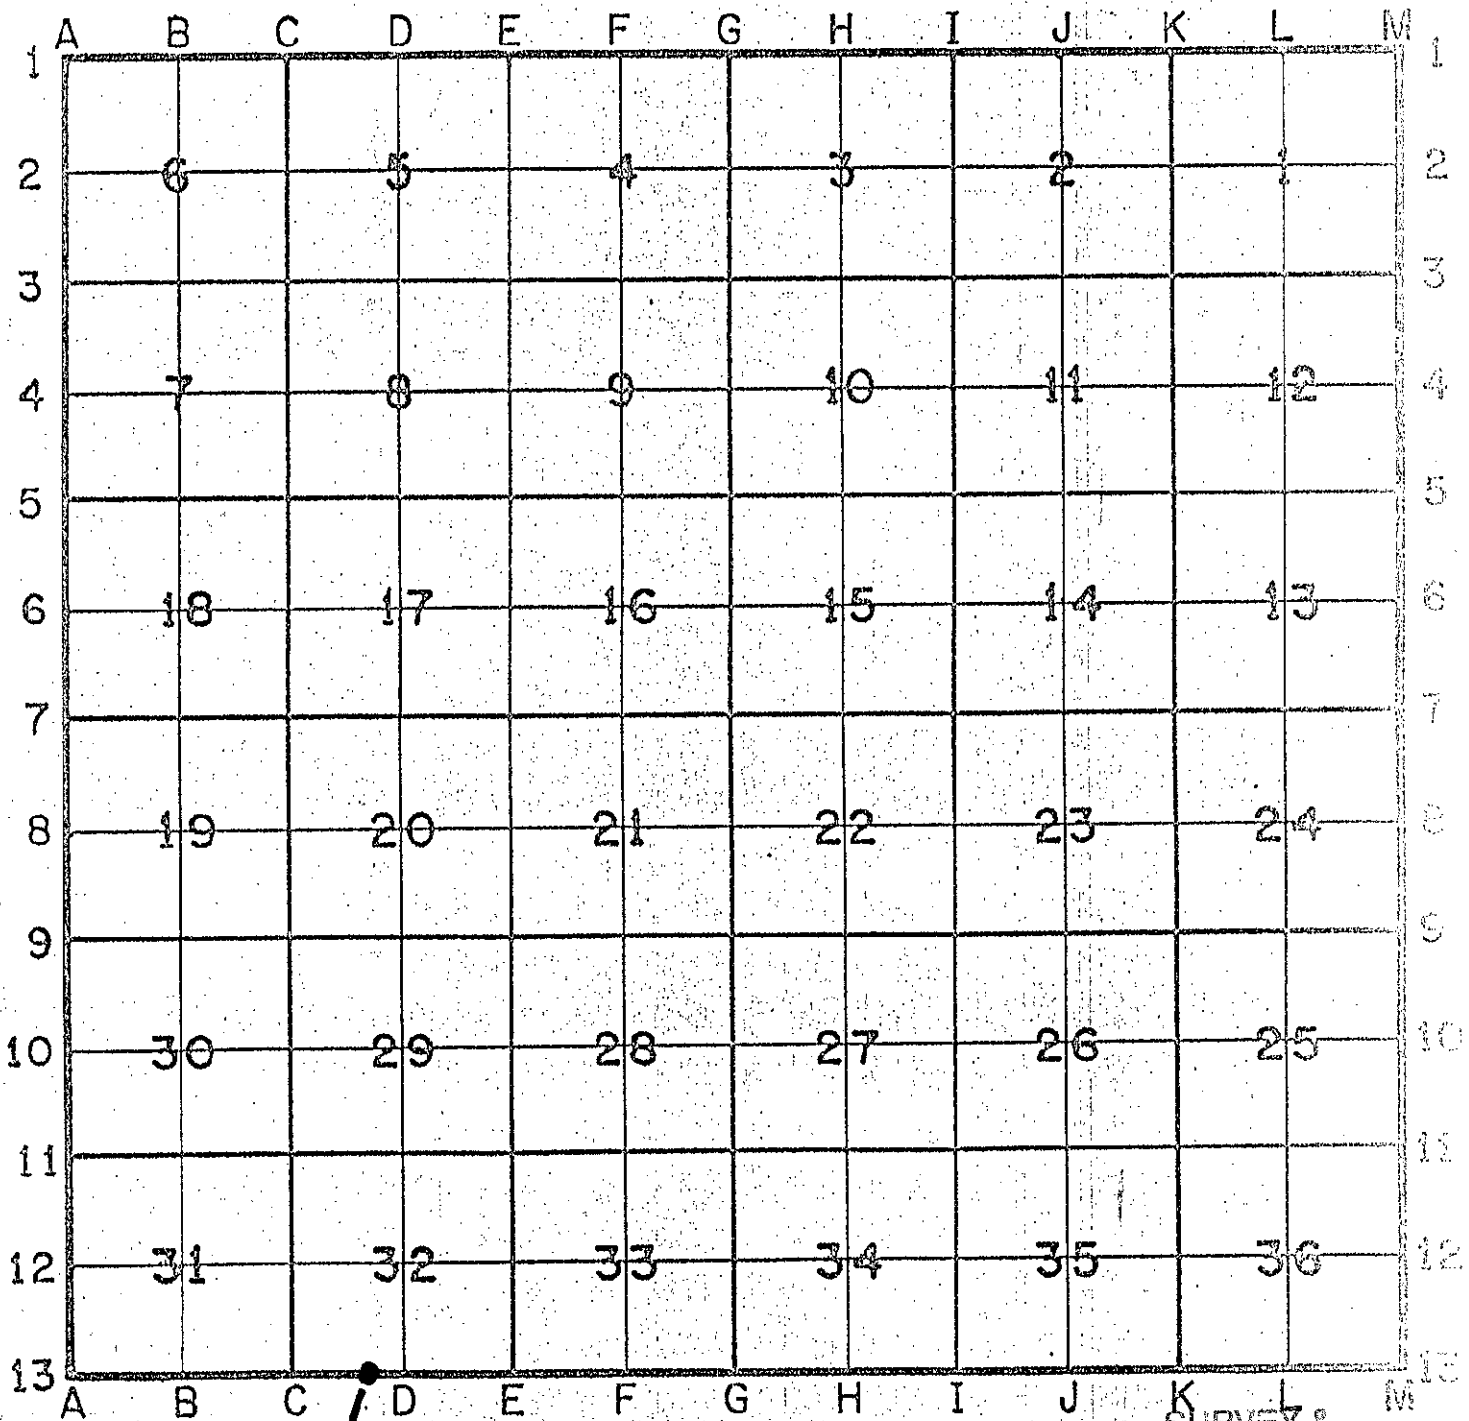

#1

T 10 N R 12 W

Tyrone Twp
Kent Co,

SURVEY &
REMONUMENTATION

MAR 01 1999

SECTION