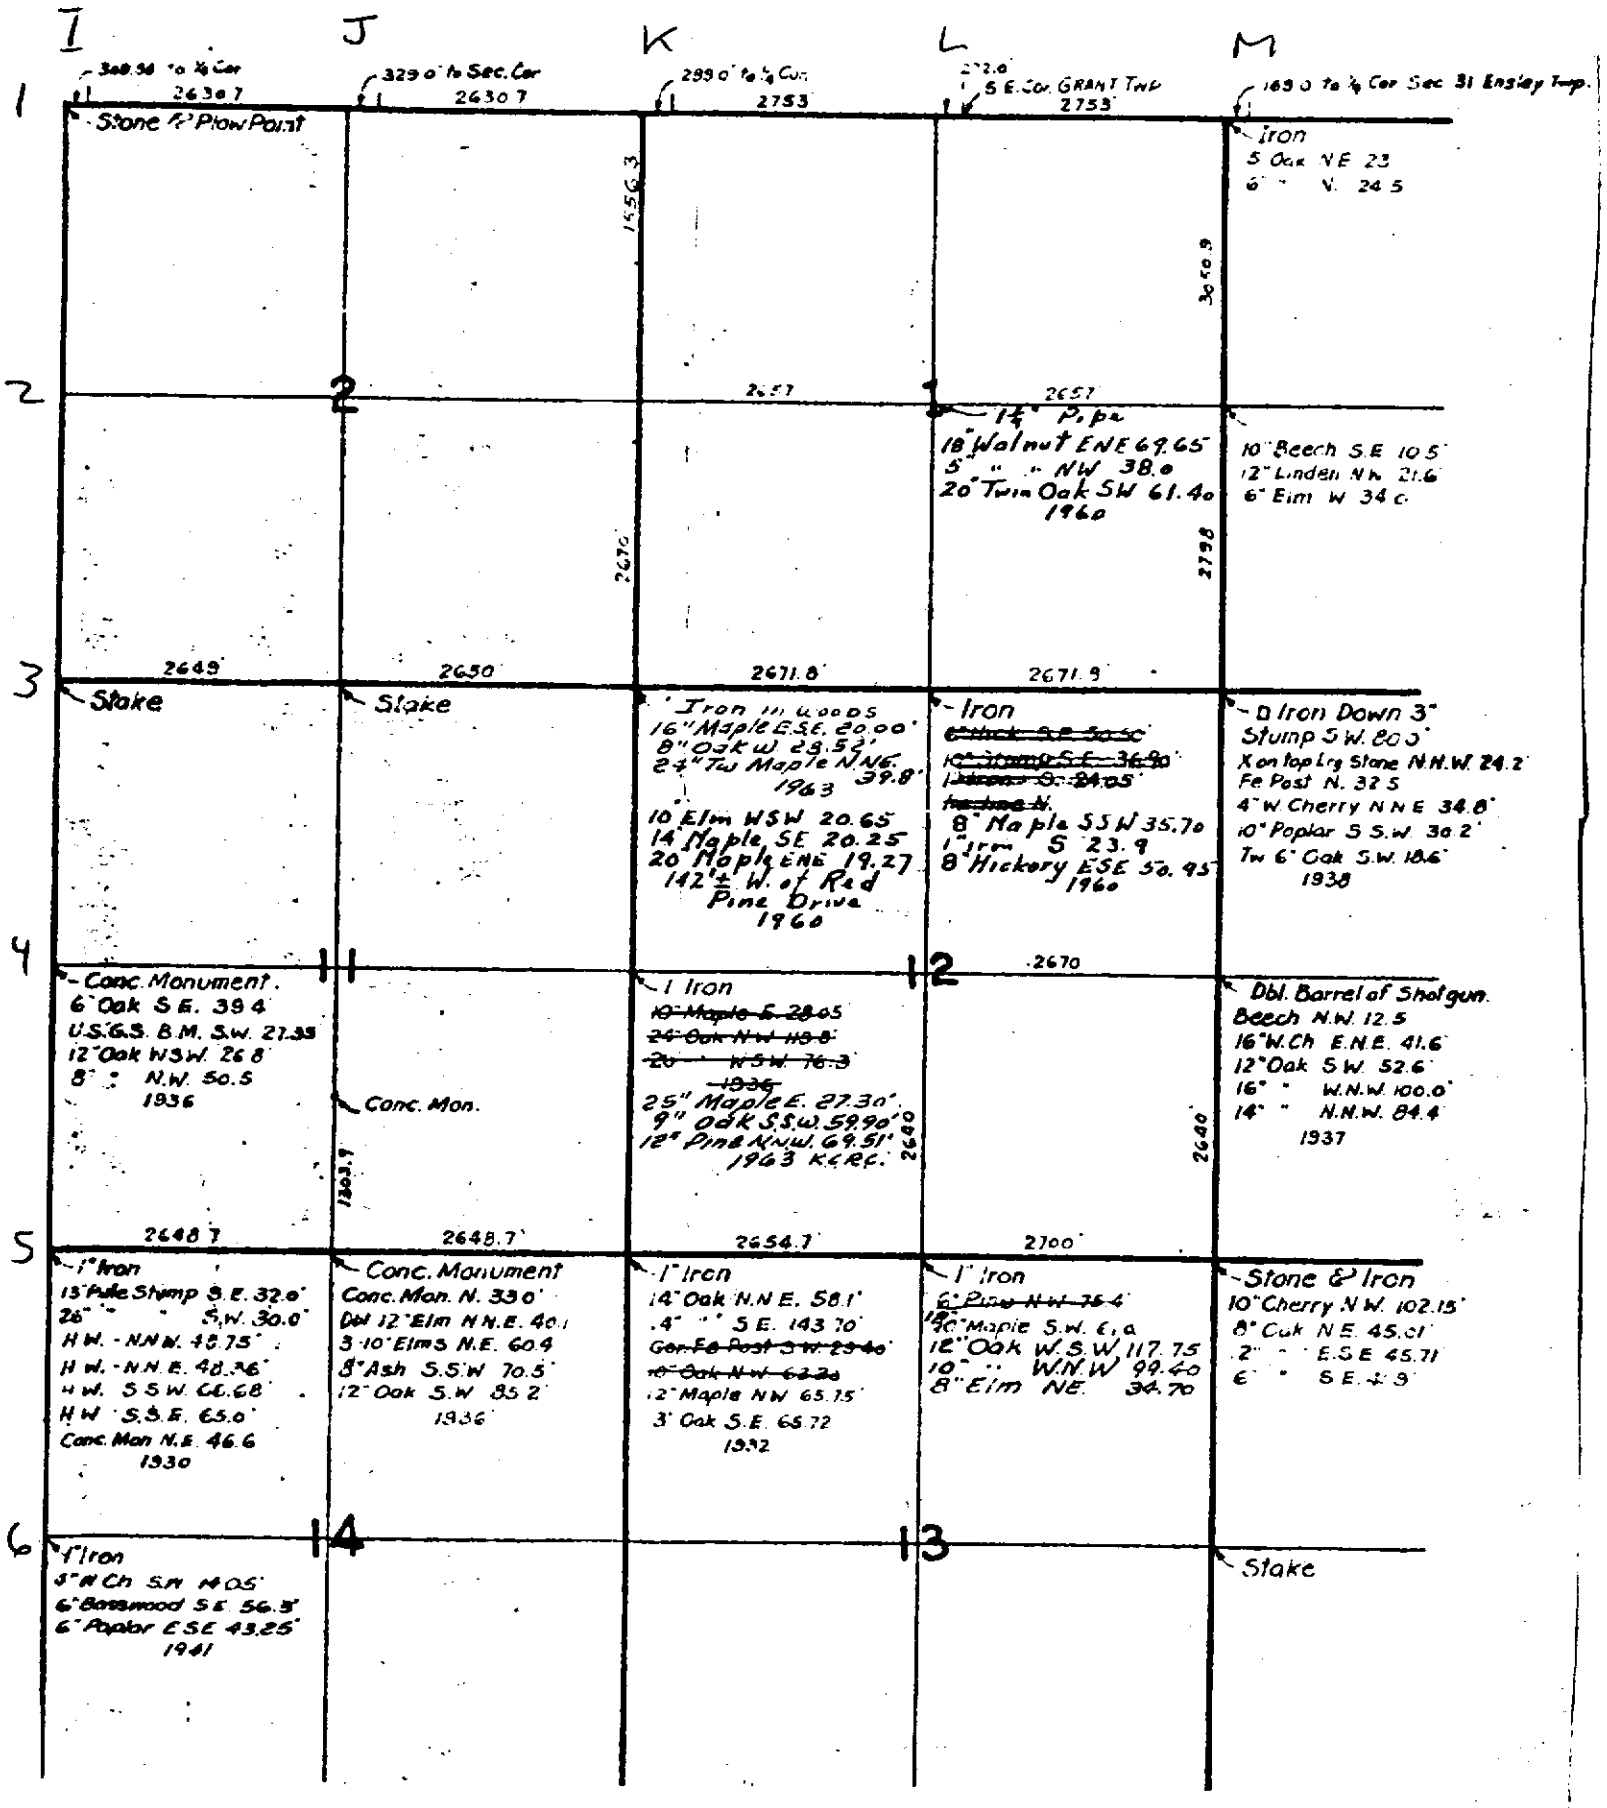

T10N, R12W
(FROM RD. COMM.)