

SURVEY & REMONUMENTATION

MAY 22 2000

KENT COUNTY REMONUMENTATION

SECTION

LAND CORNER RECORDATION CERTIFICATE
Filing Requirement of Act 74, Mich. P.A. 1970

For corners in

<u>KENT COUNTY</u> (County)	Located in:	Corner Code #
	Tyrone Twp.	
1. Public Land Survey	T 10N R 12W	A-1
	T _____ R _____	_____
	T _____ R _____	_____
	T _____ R _____	_____
2. Property Controlling in Section	S _____ T _____ R _____	_____
	S _____ T _____ R _____	_____
3. Miscellaneous Property in Sec.	S _____ T _____ R _____	_____
	S _____ T _____ R _____	_____

1999 NOV - 4 AM 8:36
 REGISTERED FOR RECORD
 STATE OF MICHIGAN
 COUNTY OF KEWASAW
 RECEIVED FOR RECORD
 REG. OF DEEDS
 11482
 Register of Deeds Stamp & File Number

4. Lot No. _____, Recorded Plat _____
 5. Private Claims _____

I, Kirk Breiteis, in a field survey on Sept. 8, 1999 do hereby state that under requirements of P.A. 74, Michigan P.A. of 1970, the corner points mentioned in lines 1 and 2 above were in conformance with regulations and rules therefore as required in the current manual of survey instructions of the United States Department of the Interior, Bureau of Land Management or by a decree of a Court of Law and /or that the corner points mentioned in lines 3, 4 and 5 above were in conformance with the rules of the Michigan Board of Land Surveyors or by a Decree of a Court of Law; established, re-established, monumented, recovered, found as expressed below:

NOTE: Not more than 2 corners, all in the same town and range, may be recorded on this certificate.

A	B	C	D	E	F	G	H	I	J	K	L	M
1												
2	6	5	4	3	2	1						
3												
4	7	8	9	10	11	12						
5												
6	10	17	16	15	14	13						
7												
8	19	20	21	22	23	24						
9												
10	30	29	28	27	26	25						
11												
12	31	32	33	34	35	36						
13												

P.A. 345 1983 KENT COUNTY
 PEER APPROVED 9/23/99
 CHAIRMAN [Signature]

A. Description of original monument and accessories and/or subsequent restoration:

A-1 1837	GLO	Brookfield	Set Post
1939	Kent Co. Wits		1 1/4" Iron
1977	LCRC #1061	Campbell	1" Pipe
1983	LCRC #3395	Byl	Set Kent County Monument on Twp. line
1994	LCRC #7521	J. Glaza	Kent County Monument

The position of this corner was previously approved by the Kent County Remonumentation Peer Group, monumented by William R. Byl on 5-26-83 and was recorded per LCRC #3395.

B. Description of corner evidence found and/or method applied in restoring or reestablishing corner:


A-1 Found Kent County Monument (Harrison) per wits of above LCRC as set by William R. Byl on Twp. line. Said 1 1/4" Iron with stones, brick and crockery was 1.23' South of Twp. line and checks with Kent Co. Wits. and LCRC #1061.
 LCRC #3395

Nail & Remon. tag P. Pole	S55°W 220.42'	Nail & Remon. tag P. Pole	S55°W 220.42'
Nail & Remon. tag 30" Tw. Ash	S55°W 25.97'	Nail & Remon. tag 36" Tw. Ash	S55°W 25.86'
C/L street sign	N50°E 55.97'	C/L street sign	N50°E 56.39'
NE corner house foundation	S30°E 191.47'	NW corner house foundation	S20°E 168.03'
NW corner house foundation	S20°E 168.12'	Nail & Remon. tag P. Pole	N40°W 222.46'
Newaygo Co. corner	East 35.73'	Cast Iron Mon.	East 34.73'

The selected location is accepted by me and is generally accepted by professional surveyors as the best available evidence of the position of the original corner.

C. Description of monument for corner and accessories established to perpetuate locating the position of the corner:

A-1 Standard Kent County Monument	
Nail & KC Remon. tag N. side P. Pole	S55°W 220.42'
C/L street sign	N50°E 56.33'
NW corner house foundation	S20°E 168.10'
Nail & KC Remon. tag NE side P. Pole	N40°W 222.44'
Newaygo Co. Mon. (B-13, Grant Twp.)	East 34.78'

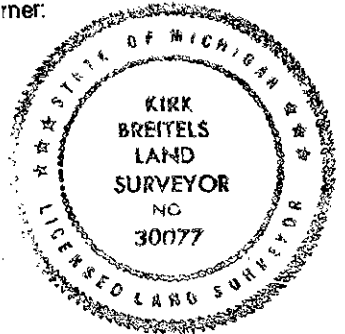

Signed by [Signature]
 Surveyor's Michigan License No. 30077

Date 10/28/99