

MAY 22 2000 KENT COUNTY REMONUMENTATION

SECTION LAND CORNER RECORDATION CERTIFICATE
 Filing Requirement of Act 74, Mich. P.A. 1970

For corners in

KENT COUNTY
 (County)

Located In:

Corner Code #

Tyrone Twp.

1. Public Land Survey

T 10 N R 12 W

A-2

T R

T R

T R

2. Property Controlling in Section

S T R

S T R

3. Miscellaneous Property in Sec.

S T R

S T R

REG. OF DEEDS
 1999 MAR 24 AM 8:00
 STATE OF MICHIGAN
 COUNTY OF KENT
 RECEIVED FOR RECORD
 11120
 Register of Deeds Stamp & File Number

4. Lot No. _____, Recorded Plat _____
 5. Private Claims _____

	A	B	C	D	E	F	G	H	I	J	K	L	M
1													
2	6			5			4			3			1
3													
4	7			8			9			10			12
5													
6	18			17			16			15			13
7													
8	19			20			21			22			24
9													
10	30			29			28			27			25
11													
12	31			32			33			34			36
13													

I, Kirk Breitels, in a field survey on Jan. 22, 1999 do hereby state that under requirements of P.A. 74, Michigan P.A. of 1970, the corner points mentioned in lines 1 and 2 above were in conformance with regulations and rules therefore as required in the current manual of survey instructions of the United States Department of the Interior, Bureau of Land Management or by a decree of a Court of Law and /or that the corner points mentioned in lines 3, 4 and 5 above were in conformance with the rules of the Michigan Board of Land Surveyors or by a Decree of a Court of Law; established, re-established, monumented, recovered, found as expressed below:

NOTE: Not more than 2 corners, all in the same town and range, may be recorded on this certificate.

A. Description of original monument and accessories and/or subsequent restoration:

A-2 1837	GLO	Brookfield	Set Post
1939	Kent Co. Wits		Concrete Monument
1977	LCRC #1061	Campbell	Found 1/2" Bar - Set 1" Pipe
1985	LCRC #4277	Ochs	Set Kent County Monument
1994	LCRC #7518	J. Glaza	Kent County Monument

P.A. 345 1980 KENT COUNTY
 PEER APPROVED 2/25/99
 CHAIRMAN [Signature]

The position of this corner was previously approved by the Kent County Remonumentation Peer Group, monumented by Norman L. Ochs on 9-17-85 and was recorded per LCRC #4277.

B. Description of corner evidence found and/or method applied in restoring or reestablishing corner:

A-2 Found Kent County Monument (Harrison) per witnesses from above LCRC as set by Norman L. Ochs in place of the Concrete Monument he found. Said Concrete Monument checks with Kent Co. Wits. and information of other surveyors. Corner per LCRC #1061 was determined to be incorrect and was removed.


LCRC #4277	Nail & Remon. tag 16" Pine	S50°E 64.25'
	Nail & Remon. tag 15" Poplar	N80°W 44.00'
	Nail & Remon. tag 14" Poplar	N25°W 61.00'
	Nail & Remon. tag 16" Pine	S20°W 82.07'
	In C/L N-S gravel road ±	
LCRC #7518	Nail & Remon. tag 18" Pine	S50°E 64.18'
	Nail & Remon. tag 14" Poplar	N80°W 43.70'
	Nail & Remon. tag 14" Poplar	N25°W 60.68'
	Nail & Remon. tag 18" Pine	S20°W 82.20'
	Nail & Remon. tag 12" Sassafras	N40°E 44.18'

The selected location is accepted by me and is generally accepted by professional surveyors as the best available evidence of the position of the original corner.

C. Description of monument for corner and accessories established to perpetuate locating the position of the corner:

A-2 Standard Kent County Monument

Nail & KC Remon. tag NE side 22" Pine	S50°E 64.20'
Nail & KC Remon. tag N. side 16" Poplar	N80°W 43.70'
Nail & KC Remon. tag NE side 16" Poplar	N25°W 60.59'
Nail & KC Remon. tag W. side 22" Pine	S20°W 82.16'
Nail & KC Remon. tag SE side 14" Sassafras	N40°E 44.11'
In C/L N-S gravel road ±	

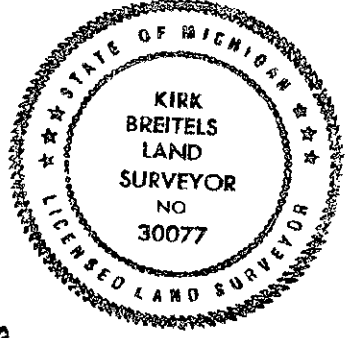

Signed by [Signature]
 Surveyor's Michigan License No. 30077

Date 2/25/99