

MAY 22 2000

KENT COUNTY REMONUMENTATION

SECTION

LAND CORNER RECORDATION CERTIFICATE  
Filing Requirement of Act 74, Mich. P.A. 1970

For corners in

KENT COUNTY

(County)

Located In:

Corner Code #

Tyrone Twp.

T10N R 12W

B-3

1. Public Land Survey

T R

2. Property Controlling in Section

S T R

3. Miscellaneous Property in Sec.

S T R

S T R

4. Lot No. \_\_\_\_\_, Recorded Plat \_\_\_\_\_

5. Private Claims \_\_\_\_\_

I, Kirk Breitels, in a field survey on Feb. 15, 19 99 do hereby state that under requirements of P.A. 74, Michigan P.A. of 1970, the corner points mentioned in lines 1 and 2 above were in conformance with regulations and rules therefore as required in the current manual of survey instructions of the United States Department of the Interior, Bureau of Land Management or by a decree of a Court of Law and/or that the corner points mentioned in lines 3, 4 and 5 above were in conformance with the rules of the Michigan Board of Land Surveyors or by a Decree of a Court of Law; established, re-established, monumented, recovered, found as expressed below:

NOTE: Not more than 2 corners, all in the same town and range, may be recorded on this certificate.

A. Description of original monument and accessories and/or subsequent restoration:

B-3 1837	GLO	Whitcomb	Set Post
	Kent Co. Wits		Iron
1979	LCRC #1315	Nederveld	3/4" Iron in Mon. Box
1982	LCRC #2639	Jonker	Set Kent County Monument in Mon. Box
1994	LCRC #7537	J. Glaza	Kent County Monument

The position of this corner was previously approved by the Kent County Remonumentation Peer Group, monumented by Robert J. Jonker on 2-4-82 and was recorded per LCRC #2639.

B. Description of corner evidence found and/or method applied in restoring or reestablishing corner:

B-3 Found Kent County Monument (Harrison) per witnesses from above LCRC as set by Robert J. Jonker in place of the Iron he found in a Mon. Box. Said Iron checks with LCRC #1315. No Kent Co. Wit. remain.  
LCRC #2639

PK Nail N. edge B.T.	N45°W	15.0'	Rerod	N00°E	15.00'
PK Nail N. edge B.T.	N50°E	15.0'	Rerod	S00°E	15.00'
PK Nail S. edge B.T.	S50°E	15.0'	NE corner metal pole barn	S70°E	276.78'
PK Nail S. edge B.T.	S50°W	15.0'	SW corner Sec. 6, (Harrison Mon.)	N90°W	2400.83'
C/L 3" Cherry	S30°E	52.0'	On C/L E-W bit. road		
C/L 2" Cherry	S43°W	61.3'	In line with ext. tree row to North		

The selected location is accepted by me and is generally accepted by professional surveyors as the best available evidence of the position of the original corner.


C. Description of monument for corner and accessories established to perpetuate locating the position of the corner:

B-3 Standard Kent County Monument		Rerod	N00°E	15.07'	
C/L 3" Apple	S25°W	73.7'	Rerod	S00°W	15.03'
C/L 3" Apple	S30°E	69.8'	NE cor. metal pole barn	S70°E	276.84'
C/L 1" Cherry	N40°E	67.1'	SW cor. Sec. 6 (Harrison Mon.)	West	2400.83'
C/L 1" Cherry	N25°W	72.7'			

STATE OF MICHIGAN  
COUNTY OF KENT  
RECEIVED FOR RECORD  
1999 MAR 24 AM 9:10  
REG. OF DEEDS

11126

Register of Deeds Stamp & File Number

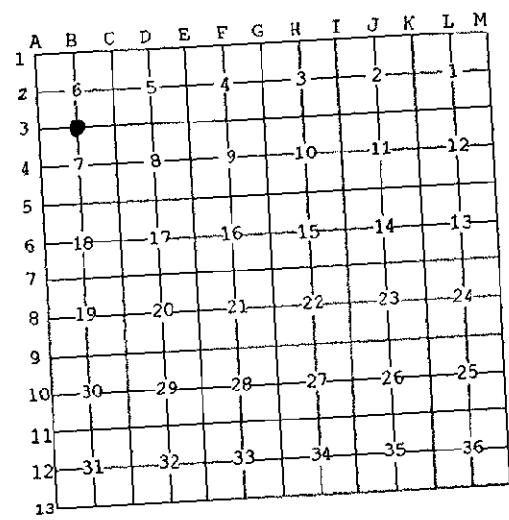

P.A. 345 1990 KENT COUNTY  
PEER APPROVED 2/25/99  
CHAIRMAN Harry Baker



Signed by Kirk Breitels  
Surveyor's Michigan License No. 30077

Date 2/25/99