

\$7.00
\$2.00

MAY 22 2000

KENT COUNTY REMONUMENTATION

LAND CORNER RECORDATION CERTIFICATE
Filing Requirement of Act 74, Mich. P.A. 1970

SECTION

STATE OF MICHIGAN
COUNTY OF KENT
RECEIVED FOR RECORD
1999 NOV -4 AM 8:37

REG. OF DEEDS

11489

Register of Deeds Stamp & File Number

For corners in

KENT COUNTY
(County)

Located In:

Corner Code #

Tyrone Twp.

1. Public Land Survey

T10N R12W

B-11

2. Property Controlling in Section

S T R

3. Miscellaneous Property in Sec.

S T R

4. Lot No. _____, Recorded Plat _____
5. Private Claims _____

I, Kirk Breitels, in a field survey on Sept. 21, 1999 do hereby state that under requirements of P.A. 74, Michigan P.A. of 1970, the corner points mentioned in lines 1 and 2 above were in conformance with regulations and rules therefore as required in the current manual of survey instructions of the United States Department of the Interior, Bureau of Land Management or by a decree of a Court of Law and /or that the corner points mentioned in lines 3, 4 and 5 above were in conformance with the rules of the Michigan Board of Land Surveyors or by a Decree of a Court of Law; established, re-established, monumented, recovered, found as expressed below:

NOTE: Not more than 2 corners, all in the same town and range, may be recorded on this certificate.

A	B	C	D	E	F	G	H	I	J	K	L	M
1												
2	6	5	4	3	2	1						
3												
4	7	8	9	10	11	12						
5												
6	10	17	16	15	14	13						
7												
8	19	20	21	22	23	24						
9												
10	30	29	28	27	26	25						
11	●											
12	31	32	33	34	35	36						
13												

P.A. 345 1990 KENT COUNTY
PEER APPROVED 9/23/99
CHAIRMAN Harry Huber

- A. Description of original monument and accessories and/or subsequent restoration:
- | | | |
|--------------------|----------|--------------------------|
| B-11 1837 GLO | Whitcomb | Set Post |
| 1940 Kent Co. Wits | | Concrete Monument |
| 1978 LCRC #1382 | Jonker | Concrete Monument |
| 1983 LCRC #3423 | Bueche | Set Kent County Monument |
| 1994 LCRC #7566 | J. Glaza | Kent County Monument |


The position of this corner was previously approved by the Kent County Remonumentation Peer Group, monumented by John C. Bueche on 5-17-83 and was recorded per LCRC #3423.

- B. Description of corner evidence found and/or method applied in restoring or reestablishing corner:
- B-11 Found Kent County Monument (Harrison) per witnesses from above LCRC as set by John C. Bueche in place of the Concrete Monument he found. Said Concrete Monument checks with Kent Co. Wits. and LCRC #1382.
- LCRC #3423
- | | | | |
|------------------------------|--------------|------------------------------|--------------|
| Nail & Remon. tag 30" Maple | S60°E 69.29' | Nail & Remon. tag 36" Maple | S60°E 69.32' |
| Nail & Remon. tag 12" Cherry | S75°W 91.72' | Nail & Remon. tag 14" Cherry | S75°W 91.70' |
| Nail & Remon. tag 4" Maple | S45°W 51.48' | Nail & Remon. tag 8" Maple | S45°W 51.39' |
| PK Nail P. Pole | N15°E 35.51' | PK Nail P. Pole | N15°E 35.51' |
| Cut Nail 30" Maple | S05°W 28.17' | Nail & Remon. tag 34" Maple | S05°W 28.12' |
| Cut Nail 30" Maple | S40°E 41.91' | Nail & Remon. tag 30" Maple | S40°E 41.95' |

The selected location is accepted by me and is generally accepted by professional surveyors as the best available evidence of the position of the original corner.

- C. Description of monument for corner and accessories established to perpetuate locating the position of the corner:

- B-11 Standard Kent County Monument
- | | |
|---|-------------------------|
| Nail & KC Remon. tag N. side 36" Maple | S60°E 69.32' |
| Nail & KC Remon. tag N. side 14" Cherry | S75°W 91.70' |
| Nail & KC Remon. tag E. side 8" Maple | S45°W 51.36' |
| Nail & KC Remon. tag E. side P. Pole | N15°E 32.86' (new pole) |
| Nail & KC Remon. tag W. side 40" Maple | S05°W 28.12' |
| Nail & KC Remon. tag NE side 30" stump | S40°E 41.87' |
- On C/L blacktop E-W

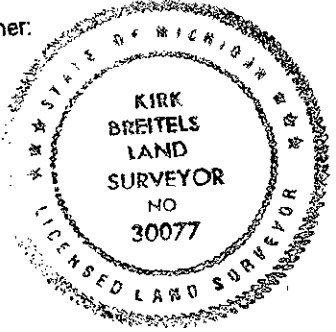

Signed by Kirk Breitels
Surveyor's Michigan License No. 30077

Date 10/28/99