

MAY 22 2000

KENT COUNTY REMONUMENTATION

LAND CORNER RECORDATION CERTIFICATE  
Filing Requirement of Act 74, Mich. P.A. 1970

SECTION

STATE OF MICHIGAN  
COUNTY OF KENT  
RECEIVED FOR RECORD  
1999 MAR 24 AM 9:00

REG. OF DEEDS

*[Handwritten Signature]*

11131

Register of Deeds Stamp & File Number


For corners in

KENT COUNTY (County)	Located In:	Corner Code #
1. Public Land Survey	T <u>10</u> N R <u>12</u> W	Tyrone Twp. C-5
	T ___ R ___	_____
	T ___ R ___	_____
	T ___ R ___	_____
2. Property Controlling in Section	S ___ T ___ R ___	_____
	S ___ T ___ R ___	_____
3. Miscellaneous Property in Sec.	S ___ T ___ R ___	_____
	S ___ T ___ R ___	_____

4. Lot No. \_\_\_\_\_, Recorded Plat \_\_\_\_\_  
5. Private Claims \_\_\_\_\_

I, Kirk Breitels, in a field survey on Jan. 15, 19 99 do hereby state that under requirements of P.A. 74, Michigan P.A. of 1970, the corner points mentioned in lines 1 and 2 above were in conformance with regulations and rules therefore as required in the current manual of survey instructions of the United States Department of the Interior, Bureau of Land Management or by a decree of a Court of Law and /or that the corner points mentioned in lines 3, 4 and 5 above were in conformance with the rules of the Michigan Board of Land Surveyors or by a Decree of a Court of Law; established, re-established, monumented, recovered, found as expressed below:

NOTE: Not more than 2 corners, all in the same town and range, may be recorded on this certificate.

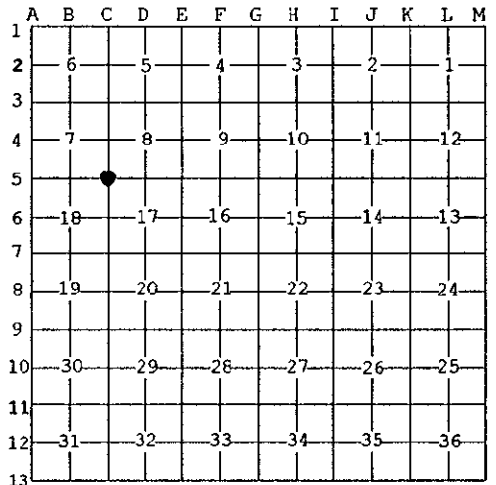

A. Description of original monument and accessories and/or subsequent restoration:

C-5 1837	GLO	Whitcomb	Set Post
1938	Kent Co. Wits		Iron
1979	LCRC #1220	Ochs	3/4" Iron in Concrete in Mon. Box
1982	LCRC #2642	Jonker	Set Kent County Monument in Mon. Box
1994	LCRC #7546	J. Glaza	Kent County Monument

P.A. 345 1990 KENT COUNTY  
PEER APPROVED 2/25/99  
CHAIRMAN [Signature]

The position of this corner was previously approved by the Kent County Remonumentation Peer Group, monumented by Robert J. Jonker on 2-4-82 and was recorded per LCRC #2642.

B. Description of corner evidence found and/or method applied in restoring or reestablishing corner:

C-5 Found Kent County Monument (Harrison) per witnesses from above LCRC as set by Robert J. Jonker in place of the 3/4" Iron in Concrete he found inside a Mon. Box. Said Iron checks with Kent Co. Wits. and LCRC #1220.  
LCRC #2642 LCRC #7546

Nail & Remon. tag P. Pole	S43°W 50.28'	Nail & Remon. tag P. Pole	S43°W 50.28'
Nail & Remon. tag top fc. post	S00°W 33.33'	Nail & Remon. tag top fc. post	S00°W 33.90'
Nail & Remon. tag 12" Poplar	S52°E 106.80'	Nail & Remon. tag 16" Aspen	S52°E 107.11'
SW face utility riser	N45°E 53.44'	Nail & Remon. tag 4" Sassafras	N47°E 118.48'
C/L stop sign	N24°W 50.4' ±	C/L stop sign	N24°W 50.1' ±
3' N. of E-W pavement & on C/L N.		2' North of E-W pavement & On C/L N. & fence line S.	

The selected location is accepted by me and is generally accepted by professional surveyors as the best available evidence of the position of the original corner.

C. Description of monument for corner and accessories established to perpetuate locating the position of the corner:

C-5 Standard Kent County Monument			
Nail & KC Remon. tag NW side P. Pole	S43°W	50.25'	
Nail & KC Remon. tag SW side 10" Oak	S40°E	103.38'	
Southerly base corner for Telephone box	N50°E	51.63'	
Nail & KC Remon. tag NE side 16" stump	S52°E	107.11'	
N. face steel gate post	S00°E	32.94'	
2' N. of E-W pavement and on line pavement to N. On fence line South			



Signed by [Signature]  
Surveyor's Michigan License No. 30077

Date 2/25/99