

\$7.00
\$2.00

MAY 22 2000

KENT COUNTY REMONUMENTATION

LAND CORNER RECORDATION CERTIFICATE
Filing Requirement of Act 74, Mich. P.A. 1970

SECTION _____

For corners in

KENT COUNTY
(County)

Located In:	Corner Code #
Tyrone Twp.	C-6
T <u>10</u> R <u>12</u> W	
T _____ R _____	
T _____ R _____	
T _____ R _____	
S _____ T _____ R _____	
S _____ T _____ R _____	
S _____ T _____ R _____	
S _____ T _____ R _____	


- 1. Public Land Survey
- 2. Property Controlling in Section
- 3. Miscellaneous Property in Sec.

- 4. Lot No. _____, Recorded Plat _____
- 5. Private Claims _____

STATE OF MICHIGAN
 COUNTY OF KENT
 RECEIVED FOR RECORD
 1999 MAR 24 AM 8:00
 REG. OF DEEDS

11132

Register of Deeds Stamp & File Number

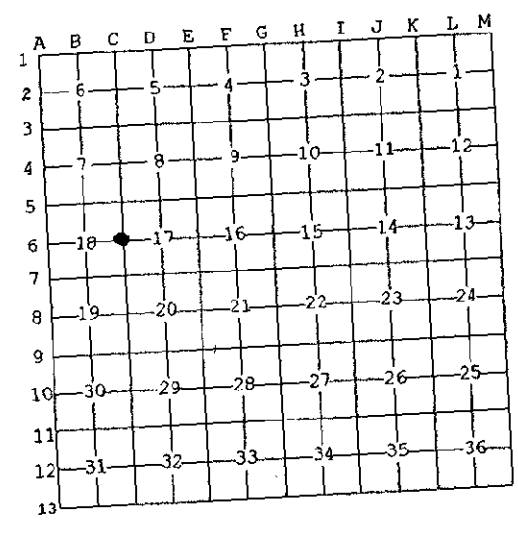

I, Kirk Breitels, in a field survey on Feb. 15, 1999 do hereby state that under requirements of P.A. 74, Michigan P.A. of 1970, the corner points mentioned in lines 1 and 2 above were in conformance with regulations and rules therefore as required in the current manual of survey instructions of the United States Department of the Interior, Bureau of Land Management or by a decree of a Court of Law and/or that the corner points mentioned in lines 3, 4 and 5 above were in conformance with the rules of the Michigan Board of Land Surveyors or by a Decree of a Court of Law; established, re-established, monumented, recovered, found as expressed below:

NOTE: Not more than 2 corners, all in the same town and range, may be recorded on this certificate.

A. Description of original monument and accessories and/or subsequent restoration:

C-6 1837	GLO	Whitcomb	Set Post
1964	Kent Co. Wits		3/4" Iron
1981	LCRC #2068	Nederveld	1 1/2" Iron in Mon. Box
1982	LCRC #3013	Starr	Set Kent County Monument in Mon. Box
1994	LCRC #7545	J. Glaza	Kent County Monument

P.A. 345 1990 KENT COUNTY
 PEER APPROVED 2/25/99
 CHAIRMAN Thomas C. Starr

The position of this corner was previously approved by the Kent County Remonumentation Peer Group, monumented by Thomas C. Starr on 8-2-82 and was recorded per LCRC #3013.

B. Description of corner evidence found and/or method applied in restoring or reestablishing corner:

C-6 Found Kent County Monument (Harrison) per witnesses from above LCRC as set by Thomas C. Starr in place of the 3/4" Iron Pipe he found in a Mon. Box. Said Iron Pipe checks with Kent Co. Wit. and LCRC #2068.
 LCRC #3013
 Nail & Remon. tag 12" Apple N40°E 48.67' Nail & Remon. tag 14" Apple N40°E 48.79'
 Nail & Remon. tag 12" Apple East 29.23' Nail & Remon. tag 14" Apple East 29.27'
 Nail & Remon. tag 12" Apple S30°E 49.57' Nail & Remon. tag 15" Apple S30°E 49.60'
 Nail & Remon. tag 4" Ash S10°W 87.84' Nail & Remon. tag 5" Ash S10°W 87.84'
 Nail & Remon. tag P. Pole S35°W 67.23' Nail & Remon. tag P. Pole S35°W 67.30'
 Nail & Remon. tag 3" Sassafras S80°W 21.57' Nail & Remon. tag 8" Oak S85°W 21.21'

The selected location is accepted by me and is generally accepted by professional surveyors as the best available evidence of the position of the original corner.

C. Description of monument for corner and accessories established to perpetuate locating the position of the corner:

C-6 Standard Kent County Monument	S10°W 87.87'
Nail & KC Remon. tag E. side 6" Ash	S35°W 67.37'
Nail & KC Remon. tag SE side P. Pole	S85°W 21.21'
Nail & KC Remon. tag N. side 10" Oak	N80°E 46.75'
C/L 1" Apple	S45°E 61.65'
C/L 1" Apple	
On tree line to West ±	
On C/L N-S bit. road ±	



Signed by Kirk Breitels
 Surveyor's Michigan License No. 30077

Date 2/25/99