

\$7.00  
\$2.00

JUN 24 2000 KENT COUNTY REMONUMENTATION

SECTION LAND CORNER RECORDATION CERTIFICATE  
Filing Requirement of Act 74, Mich. P.A. 1970

For corners in

KENT COUNTY

(County)

Located In:

Corner Code #

Tyrone Twp.  
D-5

1. Public Land Survey

T 10N R 12W

T R

T R

T R

T R

2. Property Controlling in Section

S T R

S T R

3. Miscellaneous Property in Sec.

S T R

S T R

REG. OF DEEDS

*[Signature]*


1999 MAR 24 AM 8:01

STATE OF MICHIGAN  
COUNTY OF KENT  
RECEIVED FOR RECORD

11139

Register of Deeds Stamp & File Number

4. Lot No. \_\_\_\_\_, Recorded Plat \_\_\_\_\_  
5. Private Claims \_\_\_\_\_

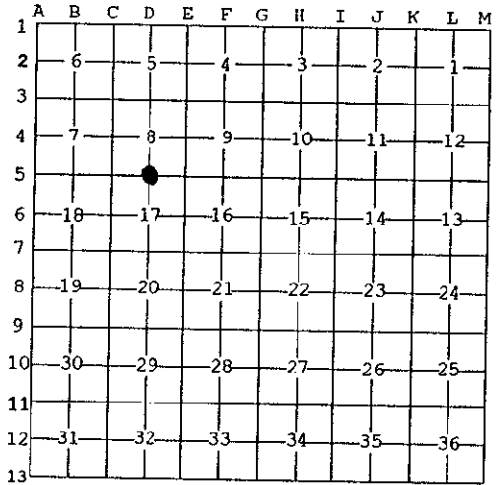

I, Kirk Breitels, in a field survey on Jan. 25, 1999 do hereby state that under requirements of P.A. 74, Michigan P.A. of 1970, the corner points mentioned in lines 1 and 2 above were in conformance with regulations and rules therefore as required in the current manual of survey instructions of the United States Department of the Interior, Bureau of Land Management or by a decree of a Court of Law and /or that the corner points mentioned in lines 3, 4 and 5 above were in conformance with the rules of the Michigan Board of Land Surveyors or by a Decree of a Court of Law; established, re-established, monumented, recovered, found as expressed below:

NOTE: Not more than 2 corners, all in the same town and range, may be recorded on this certificate.

A. Description of original monument and accessories and/or subsequent restoration:

D-5 1837	GLO	Whitcomb	Set Post
	Kent Co. Wits		No Information
1979	LCRC #1220	Ochs	Set 1/2" Rod midway and on line
1982	LCRC #2646	Jonker	Set Kent County Monument
1994	LCRC #7532	J. Glaza	Kent County Monument

P.A. 345 1990 KENT COUNTY  
PEER APPROVED 2/25/99  
CHAIRMAN [Signature]

The position of this corner was previously approved by the Kent County Remonumentation Peer Group, monumented by Robert J. Jonker on 2-17-82 and was recorded per LCRC #2646.

B. Description of corner evidence found and/or method applied in restoring or reestablishing corner:

D-5 Found Kent County Monument (Harrison) per witnesses from above LCRC as set by Robert J. Jonker in place of the 1/2" Rerod he found. Said Rerod checks with LCRC #1220.

LCRC #2646	LCRC #7532
Nail & Remon. tag 5" Cedar S40°W 85.40'	Nail & Remon. tag 8" Maple N30°W 43.53'
Nail & Remon. tag 9" Maple S30°E 75.40'	Nail & Remon. tag P. Pole S66°W 95.38'
Nail & Remon. tag 9" Maple N30°E 42.18'	Nail & Remon. tag 12" Aspen S58°E 121.18'
Nail & Remon. tag 6" Maple N30°W 43.47'	Nail & Remon. tag 12" Pine N72°E 89.41'
C/L E-W gravel road is 4' N. ±	In C/L E-W bit. road

The selected location is accepted by me and is generally accepted by professional surveyors as the best available evidence of the position of the original corner.

C. Description of monument for corner and accessories established to perpetuate locating the position of the corner:

D-5 Standard Kent County Monument

Nail & KC Remon. tag NE side 8" dead Maple	N30°W	43.55'
Nail & KC Remon. tag N. side P. Pole	S66°W	95.44'
Nail & KC Remon. tag NE side 14" Aspen	S58°E	121.21'
Nail & KC Remon. tag S. side 12" Pine	N72°E	89.48'
In C/L E-W bit. road		



Signed by *[Signature]*  
Surveyor's Michigan License No. 30077

Date 2/25/99