

MAY 28 2000

KENT COUNTY REMONUMENTATION

\$7.00
\$2.00

SECTION

LAND CORNER RECORDATION CERTIFICATE
Filing Requirement of Act 74, Mich. P.A. 1970

REG. OF DEEDS

[Signature]

1999 MAR 24 AM 8:01

STATE OF MICHIGAN
COUNTY OF KENT
RECEIVED FOR RECORD

For corners in

KENT COUNTY
(County)

Located In:

Corner Code #

Tyrone Twp.

1. Public Land Survey

T 10N R 12W

D-7

T R

T R

T R

T R

2. Property Controlling in Section

S T R

S T R

3. Miscellaneous Property in Sec.

S T R

S T R

4. Lot No. _____, Recorded Plat _____
5. Private Claims _____

I, Kirk Breitels, in a field survey on Jan. 25, 19 99 do hereby state that under requirements of P.A. 74, Michigan P.A. of 1970, the corner points mentioned in lines 1 and 2 above were in conformance with regulations and rules therefore as required in the current manual of survey instructions of the United States Department of the Interior, Bureau of Land Management or by a decree of a Court of Law and /or that the corner points mentioned in lines 3, 4 and 5 above were in conformance with the rules of the Michigan Board of Land Surveyors or by a Decree of a Court of Law; established, re-established, monumented, recovered, found as expressed below:

NOTE: Not more than 2 corners, all in the same town and range, may be recorded on this certificate.

A. Description of original monument and accessories and/or subsequent restoration:

D-7	1837	GLO	Whitcomb	Set Post
	1938	Kent Co. Wits		Iron
	1954	Williams & Works		Iron
	1983	LCRC #3687	Bueche	Set Kent County Monument
	1994	LCRC #7528	J. Glaza	Kent County Monument

P.A. 345 1990 KENT COUNTY
PEER APPROVED 2/25/99
CHAIRMAN [Signature]

The position of this corner was previously approved by the Kent County Remonumentation Peer Group, monumented by John C. Bueche on 12-5-83 and was recorded per LCRC #3687.

B. Description of corner evidence found and/or method applied in restoring or reestablishing corner:


D-7 Found Kent County Monument (Harrison) per witnesses from above LCRC as set by John C. Bueche in place of the 3/4" Iron he found. Said Iron checks with Williams & Works information. No Kent Co. Wit. remain.

LCRC #3687		LCRC #7528	
Nail & Remon. tag 8" Apple	N40°W 45.54'	Nail & Remon. tag 12" Apple	S45°W 52.67'
Nail & Remon. tag 8" Apple	N60°W 72.75'	Nail & Remon. tag top fc. post	S00°W 25.75'
Nail & Remon. tag 8" Apple	S45°W 52.63'	PK Nail in fence post	N15°E 25.22'
Nail & Remon. tag top fc. post	S00°W 25.30'	Nail & Remon. tag 6" Apple	N48°W 50.59'
PK Nail in fence post	N15°E 25.06'	On C/L gravel road E-W	
		On fence lines N-S	

The selected location is accepted by me and is generally accepted by professional surveyors as the best available evidence of the position of the original corner.

C. Description of monument for corner and accessories established to perpetuate locating the position of the corner:

D-7 Standard Kent County Monument	
Nail & KC Remon. tag W. side 12" Apple	S45°W 52.67'
Nail & KC Remon. tag top of fence post (leaning)	S00°W 25.87'
PK Nail W. side fence post (leaning)	N15°E 25.40'
Nail & KC Remon. tag SW side 8" Apple	N48°W 50.67'
Cut small "+" top CMP culv.	S80°E 143.63'
On fence line South and in C/L gravel road E-W	
Fence to North is 6' East	

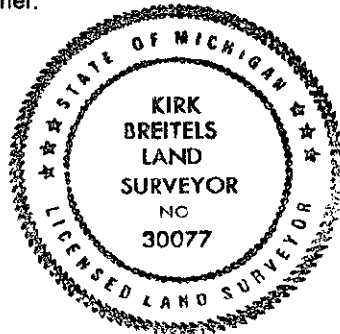

Signed by [Signature]
Surveyor's Michigan License No. 30077

Date 2/25/99

