

\$7.00
\$2.00

MAY 22 2000

KENT COUNTY REMONUMENTATION

LAND CORNER RECORDATION CERTIFICATE Filing Requirement of Act 74, Mich. P.A. 1970

SECTION

For corners in

KENT COUNTY
(County)

Located In:

Corner Code #
Tyrone Twp.

1. Public Land Survey	T	10N	R	12W	D-9
	T		R		
	T		R		
	T		R		
2. Property Controlling in Section	S	T	R		
	S	T	R		
3. Miscellaneous Property in Sec.	S	T	R		
	S	T	R		

STATE OF MICHIGAN
 COUNTY OF KENT
 RECEIVED FOR RECORD
 1999 MAR 24 AM 8:01
 REG. OF DEEDS


11141

Register of Deeds Stamp & File Number

- 4. Lot No. _____, Recorded Plat _____
- 5. Private Claims _____

I, Kirk Breitels, in a field survey on Jan. 26, 1999 do hereby state that under requirements of P.A. 74, Michigan P.A. of 1970, the corner points mentioned in lines 1 and 2 above were in conformance with regulations and rules therefore as required in the current manual of survey instructions of the United States Department of the Interior, Bureau of Land Management or by a decree of a Court of Law and for that the corner points mentioned in lines 3, 4 and 5 above were in conformance with the rules of the Michigan Board of Land Surveyors or by a Decree of a Court of Law; established, re-established, monumented, recovered, found as expressed below:

NOTE: Not more than 2 corners, all in the same town and range, may be recorded on this certificate.

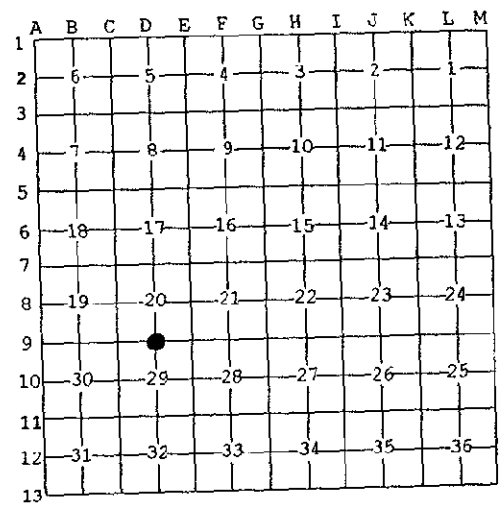

A. Description of original monument and accessories and/or subsequent restoration:

D-9 1837	GLO	Whitcomb	Set Post
1944	Kent Co. Wits.		Iron
1973	LCRC #463	Spicer	"T" Iron
1982	LCRC #2647	Jonker	Set Kent County Monument in Mon. Box
1994	LCRC #7575	J. Glaza	Kent County Monument

P.A. 345 1990 KENT COUNTY
 PEER APPROVED 2/25/99
 CHAIRMAN Harry Huber

The position of this corner was previously approved by the Kent County Remonumentation Peer Group, monumented by Robert J. Jonker on 2-10-82 and was recorded per LCRC #2647.

B. Description of corner evidence found and/or method applied in restoring or reestablishing corner:

D-9 Found Kent County Monument (Harrison) per witnesses from above LCRC as set by Robert J. Jonker in place of the 1/2" Iron he found inside a Mon. Box. Said Iron checks with LCRC #463. No Kent Co. Wits. remain.	LCRC #2647	LCRC #7575
Nail & Remon. tag P. Pole	N80°E 244.0'	Nail & Remon. tag P. Pole N80°E 243.85'
C/L steel post	N02°W 35.61'	C/L steel post N02°W 35.61'
C/L steel post	N32°E 41.25'	C/L steel post N32°E 41.25'
SE corner house foundation	N52°W 166.10'	SE corner house foundation N52°W 165.89'
On C/L E-W pavement		On C/L E-W pavement

The selected location is accepted by me and is generally accepted by professional surveyors as the best available evidence of the position of the original corner.

C. Description of monument for corner and accessories established to perpetuate locating the position of the corner:

D-9 Standard Kent County Monument in Mon. Box	
Nail & KC Remon. tag W. side corner fence post	S20°E 37.49'
Nail & KC Remon. tag NE side P. Pole	N55°W 104.02'
SE corner house foundation	N52°W 165.95'
C/L steel post - new location	N15°W 36.4'
Nail & KC Remon. tag S. side P. Pole	N80°E 243.90'
On C/L E-W pavement	



Signed by Kirk Breitels
 Surveyor's Michigan License No. 30077

Date 2/25/99