

SURVEY &
RECORDATION

MAY 28 2000

KENT COUNTY REMONUMENTATION

LAND CORNER RECORDATION CERTIFICATE
Filing Requirement of Act 74, Mich. P.A. 1970

27.00
22.00

SECTION

REG. OF DEEDS

STATE OF MICHIGAN
COUNTY OF KENT
RECEIVED FOR RECORD
1999 DEC 15 AM 8:56

For corners in

KENT COUNTY (County)	Located In:	Corner Code #
1. Public Land Survey	T <u>10</u> N R <u>12</u> W	Tyrone Twp. D-12
	T ___ R ___	_____
	T ___ R ___	_____
	T ___ R ___	_____
2. Property Controlling in Section	S ___ T ___ R ___	_____
	S ___ T ___ R ___	_____
3. Miscellaneous Property in Sec.	S ___ T ___ R ___	_____
	S ___ T ___ R ___	_____

11604

Register of Deeds Stamp & File Number

4. Lot No. _____, Recorded Plat _____
5. Private Claims _____

I, Kirk Breitels, in a field survey on Aug. 17, 19 99 do hereby state that under requirements of P.A. 74, Michigan P.A. of 1970, the corner points mentioned in lines 1 and 2 above were in conformance with regulations and rules therefore as required in the current manual of survey instructions of the United States Department of the Interior, Bureau of Land Management or by a decree of a Court of Law and /or that the corner points mentioned in lines 3, 4 and 5 above were in conformance with the rules of the Michigan Board of Land Surveyors or by a Decree of a Court of Law; established, re-established, monumented, recovered, found as expressed below:

NOTE: Not more than 2 corners, all in the same town and range, may be recorded on this certificate.

	A	B	C	D	E	F	G	H	I	J	K	L	M
1													
2	6		5		4		3		2		1		
3													
4	7		8		9		10		11		12		
5													
6	18		17		16		15		14		13		
7													
8	19		20		21		22		23		24		
9													
10	30		29		28		27		26		25		
11													
12	31		32		33		34		35		36		
13													

A. Description of original monument and accessories and/or subsequent restoration:

- D-12 1837 GLO Not Set
1915-57 Williams & Works Iron at C 1/4
22.8' Fence Post N 68.3' 20" Maple NE 39.8' Apple SW
1964 Kent Co. Wits 3/4" Iron in conc.
N 40" Elm 22.35' WNW N. end culv. 50.20' WSW S. end culv. 50.10' Fc. Post S 38.05'
1971 LCRC #88 Spicer Concrete Monument
CP Pole N 49.89' 6" Elm S 46.83' C/L N. end culv. N70°W 50.20' C/L S. end culv. S80°W 50.00'


P.A. 345 1999 KENT COUNTY
PEER APPROVED 8/26/99
CHAIRMAN *[Signature]*

B. Description of corner evidence found and/or method applied in restoring or reestablishing corner:

D-12 Found Rerod over Conc. Monument in centerline of E-W asphalt road - no previous witnesses remain. The location of the Rerod-Conc. Mon. fits measurements of work done by Roosien in Section 32 for the South township line of Tyrone Twp. etc. At that time he found a PK Nail at the C 1/4 corner, in C/L of E-W pavement 2.1' North and 2.0' East of intersection of 1/4 lines (S 1/4 corner computed at split of mile with a jog computed at 16.08' West of N 1/4 corner of 5-9-12). The Rerod-Conc. Mon. is 2.3' North & 1.9' West of intersection of 1/4 lines (S 1/4 corner was monumented at GLO prorated jog of 8.25' West of N 1/4 corner 5-9-12, creating an E-W difference at the C 1/4 corner of 32-10-12 of 4' ± different than that reported by Roosien - 3.9' meas.). The Rerod-Conc. Mon. also fits work done by others over the years.
The Rerod over the Conc. Monument is accepted by me and is generally accepted by professional surveyors as the best available evidence of the position of the corner.

C. Description of monument for corner and accessories established to perpetuate locating the position of the corner:

- D-12 Set Standard Kent County Monument in Mon. Box over Conc. Monument in place of the Rerod.
Nail & KC Remon. tag E. side 12" Elm S10°W 50.39'
Nail & KC Remon. tag E. side P. Pole N05°E 50.33'
Nail & KC Remon. tag NE side P. Pole N45°W 82.43'
PK Nail top of N. end C.M.P. N60°W 53.13'
PK Nail top of S. end C.M.P. S70°W 52.65'

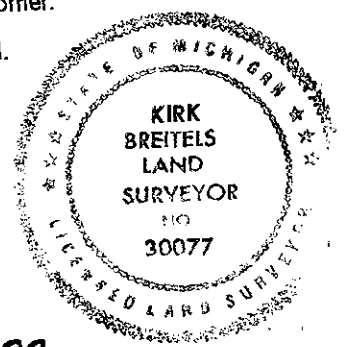

Signed by *[Signature]*
Surveyor's Michigan License No. 30077

Date 12/6/99