

MAY 22 2000

KENT COUNTY REMONUMENTATION

\$7.00
\$2.00

SECTION

LAND CORNER RECORDATION CERTIFICATE
Filing Requirement of Act 74, Mich. P.A. 1970

STATE OF MICHIGAN
COUNTY OF KENT
RECEIVED FOR RECORD
1999 MAR 24 AM 9:01

For corners in

KENT COUNTY (County)	Located In:	Corner Code #
1. Public Land Survey	T 10N R 12W	Tyrone Twp. E-2
	T R	
	T R	
	T R	
2. Property Controlling in Section	S T R	
	S T R	
3. Miscellaneous Property in Sec.	S T R	
	S T R	

REG. OF DEEDS

[Handwritten Signature]


11143

Register of Deeds Stamp & File Number

4. Lot No. _____, Recorded Plat _____
5. Private Claims _____

I, Kirk Breitels, in a field survey on Feb. 9, 19 99 do hereby state that under requirements of P.A. 74, Michigan P.A. of 1970, the corner points mentioned in lines 1 and 2 above were in conformance with regulations and rules therefore as required in the current manual of survey instructions of the United States Department of the Interior, Bureau of Land Management or by a decree of a Court of Law and /or that the corner points mentioned in lines 3, 4 and 5 above were in conformance with the rules of the Michigan Board of Land Surveyors or by a Decree of a Court of Law; established, re-established, monumented, recovered, found as expressed below:

NOTE: Not more than 2 corners, all in the same town and range, may be recorded on this certificate.

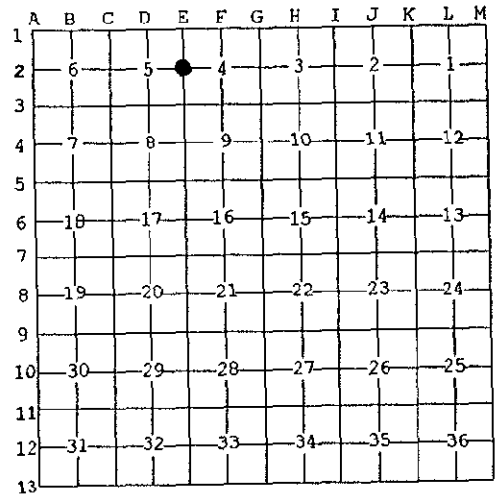

A. Description of original monument and accessories and/or subsequent restoration:

E-2	1837	GLO	Whitcomb	Set Post
	1959	Kent Co. Wits		Iron in Mon. Box
	1973	LCRC #536	Spicer	1/2" Iron in Mon. Box
	1982	LCRC #2649	Jonker	Set Kent County Monument in Mon. Box
	1994	LCRC #7542	J. Glaza	Kent County Monument

P.A. 345 1990 KENT COUNTY

PEER APPROVED 2/25/99
CHAIRMAN [Signature]

The position of this corner was previously approved by the Kent County Remonumentation Peer Group, monumented by Robert J. Jonker on 2-4-82 and was recorded per LCRC #2649.

B. Description of corner evidence found and/or method applied in restoring or reestablishing corner:

E-2 Found Kent County Monument (Harrison) per witnesses from above LCRC as set by Robert J. Jonker in place of the 1/2" Iron he found in a Mon. Box. Said Iron checks with Kent Co. Wits. and LCRC #536.

LCRC #2649	LCRC #7542
Nail & Remon. tag P. Pole S88°W 35.68'	Nail & Remon. tag P. Pole S88°W 35.64'
Nail & Remon. tag P. Pole N07°W 249.35'	Nail & Remon. tag P. Pole N07°W 249.30'
Nail & Remon. tag P. Pole S12°W 237.75'	Nail & Remon. tag P. Pole S12°W 237.68'
K.C.R.C. witness iron S88°E 50.0'	K.C.R.C. witness iron S88°E 49.98'
On C/L N-S pavement	On C/L N-S pavement
In line brush rows E-W	In line brush rows E-W

The selected location is accepted by me and is generally accepted by professional surveyors as the best available evidence of the position of the original corner.

C. Description of monument for corner and accessories established to perpetuate locating the position of the corner:

E-2 Standard Kent County Monument in Mon. Box	
Nail & KC Remon. tag S. side P. Pole	S88°W 35.68'
Nail & KC Remon. tag E. side P. Pole	N07°W 249.30'
Nail & KC Remon. tag E. side P. Pole	S12°W 237.68'
Iron Pipe	S88°E 49.98'
In C/L N-S pavement & on brush rows E-W	



Signed by [Signature]
Surveyor's Michigan License No. 30077

Date 2/25/99