

MAY 22 2000

KENT COUNTY REMONUMENTATION

SECTION LAND CORNER RECORDATION CERTIFICATE  
Filing Requirement of Act 74, Mich. P.A. 1970

\$7.00  
\$2.00

REG. OF DEEDS

STATE OF MICHIGAN  
COUNTY OF KENT  
RECEIVED FOR RECORD  
1999 MAR 24 AM 9:11

For corners in

KENT COUNTY (County)	Located in:	Corner Code #
1. Public Land Survey	T <u>10N</u> R <u>12W</u>	<u>E-4</u>
	T ___ R ___	_____
	T ___ R ___	_____
	T ___ R ___	_____
	T ___ R ___	_____
2. Property Controlling in Section	S ___ T ___ R ___	_____
	S ___ T ___ R ___	_____
3. Miscellaneous Property in Sec.	S ___ T ___ R ___	_____
	S ___ T ___ R ___	_____


11145

Register of Deeds Stamp & File Number

4. Lot No. \_\_\_\_\_, Recorded Plat \_\_\_\_\_  
5. Private Claims \_\_\_\_\_

I, Kirk Breitels, in a field survey on Feb. 15, 1999 do hereby state that under requirements of P.A. 74, Michigan P.A. of 1970, the corner points mentioned in lines 1 and 2 above were in conformance with regulations and rules therefore as required in the current manual of survey instructions of the United States Department of the Interior, Bureau of Land Management or by a decree of a Court of Law and/or that the corner points mentioned in lines 3, 4 and 5 above were in conformance with the rules of the Michigan Board of Land Surveyors or by a Decree of a Court of Law, established, re-established, monumented, recovered, found as expressed below:

NOTE: Not more than 2 corners, all in the same town and range, may be recorded on this certificate.

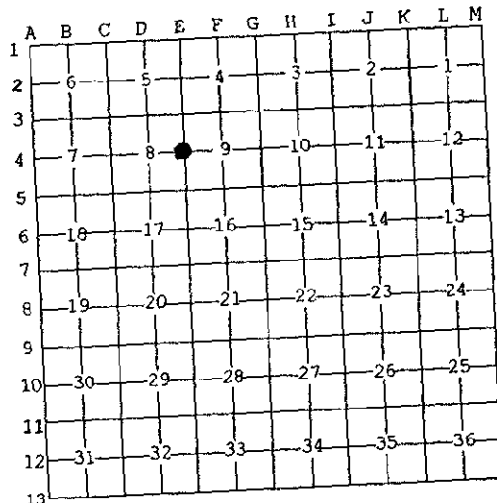

A. Description of original monument and accessories and/or subsequent restoration:

E-4 1837	GLO	Whitcomb	Set Post
1964	Kent Co. Wits		3/4" Iron
1981	LCRC #2045	E. Glaza	Iron in Mon. Box
1982	LCRC #3012	Starr	Set Kent County Monument in Mon. Box
1994	LCRC #7541	J. Glaza	Kent County Monument

P.A. 345 1990 KENT COUNTY  
PEER APPROVED 2/25/99  
CHAIRMAN Thomas C. Starr

The position of this corner was previously approved by the Kent County Remonumentation Peer Group, monumented by Thomas C. Starr on 8-2-82 and was recorded per LCRC #3012.

B. Description of corner evidence found and/or method applied in restoring or reestablishing corner:


E-4 Found Kent County Monument (Harrison) per witnesses from above LCRC as set by Thomas C. Starr in place of the 1/2" Iron Pipe he found in a Mon. Box. Said Iron Pipe checks with Kent Co. Wits. and LCRC #2045.

LCRC #3012	LCRC #7541
Nail & Remon. tag 6" Pine	S80°W 43.72' Nail & Remon. tag 10" Pine
Nail & Remon. tag 6" Pine	S45°W 68.07' Nail & Remon. tag 10" Pine
Nail & Remon. tag P. Pole	S20°W 97.34' Nail & Remon. tag P. Pole
Nail & Remon. tag P & T Pole	S80°E 57.99' Nail & Remon. tag P & T Pole
Nail & Remon. tag P. Pole	N15°W 166.70' Nail & Remon. tag P. Pole
C/L 3" Maple	N65°E 99.5' C/L 3" Maple

The selected location is accepted by me and is generally accepted by professional surveyors as the best available evidence of the position of the original corner.

C. Description of monument for corner and accessories established to perpetuate locating the position of the corner:

E-4 Standard Kent County Monument in Mon. Box	
Nail & KC Remon. tag S. side 12" Stump	S80°W 43.78'
Nail & KC Remon. tag S. side 12" Stump	S45°W 67.91'
Nail & KC Remon. tag E. side P. Pole	S20°W 97.34'
Nail & KC Remon. tag S. side P & T Pole	S80°E 57.98'
Nail & KC Remon. tag E. side P. Pole	N15°W 166.70'
N. end conc. culvert (notch)	N45°E 55.66'

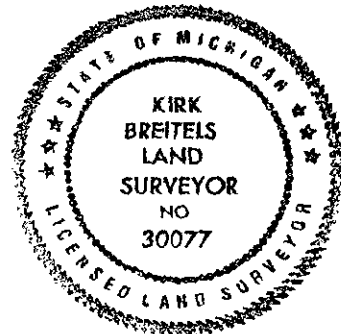

Signed by

Kirk Breitels

Surveyor's Michigan License No. 30077

Date

2/25/99