

RECORDATION & REGISTRATION

RECORDATION

RECORDATION

RECORDATION

RECORDATION

\$7.00
\$2.00

MAY 24 2000

KENT COUNTY REMONUMENTATION

SECTION

LAND CORNER RECORDATION CERTIFICATE

Filing Requirement of Act 74, Mich. P.A. 1970

For corners in
KENT COUNTY
(County)

Located in: Tyrone Twp.
Corner Code # E-8


1. Public Land Survey	T <u>10</u> N	R <u>12</u> W	_____
	T _____	R _____	_____
	T _____	R _____	_____
	T _____	R _____	_____
2. Property Controlling in Section	S _____	T _____	R _____
	S _____	T _____	R _____
3. Miscellaneous Property in Sec.	S _____	T _____	R _____
	S _____	T _____	R _____

STATE OF MICHIGAN
COUNTY OF KENT
RECEIVED FOR RECORD
1999 MAR 24 AM 8:01
REQ. OF DEEDS

11149

Register of Deeds Stamp & File Number

- 4. Lot No. _____, Recorded Plat _____
- 5. Private Claims _____

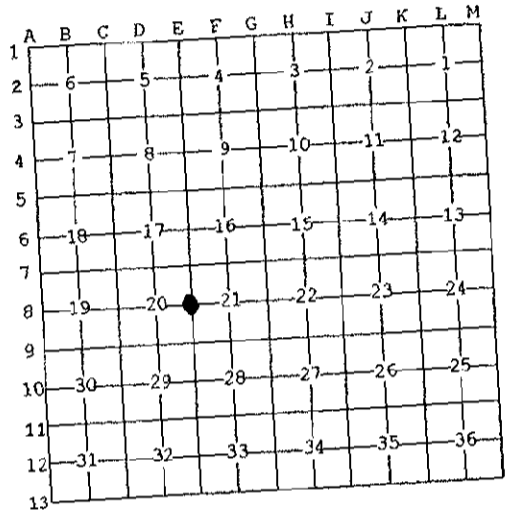

I, Kirk Breitals, in a field survey on Jan. 26, 1999 do hereby state that under requirements of P.A. 74, Michigan P.A. of 1970, the corner points mentioned in lines 1 and 2 above were in conformance with regulations and rules therefore as required in the current manual of survey instructions of the United States Department of the Interior, Bureau of Land Management or by a decree of a Court of Law and/or that the corner points mentioned in lines 3, 4 and 5 above were in conformance with the rules of the Michigan Board of Land Surveyors or by a Decree of a Court of Law; established, re-established, monumented, recovered, found as expressed below:

NOTE: Not more than 2 corners, all in the same town and range, may be recorded on this certificate.

A. Description of original monument and accessories and/or subsequent restoration:

E-8 1837	GLO	Whitcomb	Set Post
	Kent Co. Wit.		Iron
1973	LCRC #573	Spicer	1" Iron
1981	LCRC #2710	Jonker	Set Kent County Monument in Mon. Box
1994	LCRC #7588	J. Glaza	Kent County Monument

P.A. 345 1990 KENT COUNTY
PEER APPROVED 2/25/99
CHAIRMAN [Signature]

The position of this corner was previously approved by the Kent County Remonumentation Peer Group, monumented by Robert J. Jonker on 3-10-82 and was recorded per LCRC #2710.

B. Description of corner evidence found and/or method applied in restoring or reestablishing corner:

E-8 Found Kent County Monument (Harrison) per witnesses from above LCRC as set by Robert J. Jonker in place of the 1/2" Iron he found inside a Mon. Box. Said Iron checks with information provided by KCRC wit. prior to construction. No other witnesses remain.

LCRC #2710	N45°E 76.70'	Nail & Remon. tag 18" Elm	N45°E 76.99'
Nail & Remon. tag 9" Elm	S50°E 78.71'	Nail & Remon. tag 8" Tri. Box Elder	S50°E 78.89'
Nail & Remon. tag 4" Box Elder	S58°W 109.06'	Nail & Remon. tag P. Pole	S58°W 109.06'
Nail & Remon. tag P. Pole	S25°W 158.95'	Nail & Remon. tag 48" Maple	S25°W 159.52'

On C/L N-S pavement and in line fences E-W
The selected location is accepted by me and is generally accepted by professional surveyors as the best available evidence of the position of the original corner.

C. Description of monument for corner and accessories established to perpetuate locating the position of the corner:

E-8 Standard Kent County Monument in Mon. Box	N40°E 148.40'
Nail & KC Remon. tag SE side P. Pole	S50°E 78.89'
Nail & KC Remon. tag SW side Tri. 8" Box Elder	S58°W 108.96'
Nail & KC Remon. tag NW side P. Pole	S25°W 159.52'
Nail & KC Remon. tag E. side 48" Maple	
On C/L N-S pavement	



Signed by [Signature]
Surveyor's Michigan License No. 30077

Date 2/25/99