$7.00
$2.00

SECTION

KENT COUNTY REMONUMENTATION

LAND CORNER RECORDATION CERTIFICATE
Filing Requirement of Act 74, Mich. P.A. 1970

STATE OF MICHIGAN
COUNTY OF KENT
RECEIVED FOR RECORD
1999 JUL -9 AM 11:20
REGISTER OF DEEDS

For corners in

KENT COUNTY
(County)

	Located In:		Corner Code #
			Tyrone Twp.
1. Public Land Survey		T 10N R 12W	F-3
		T___ R___	
		T___ R___	
		T___ R___	
2. Property Controlling	S___	T___ R___	
in Section	S___	T___ R___	
3. Miscellaneous	S___	T___ R___	
Property in Sec.	S___	T___ R___	

11253
Register of Deeds Stamp & File Number

4. Lot No. _____ , Recorded Plat _____
5. Private Claims _____

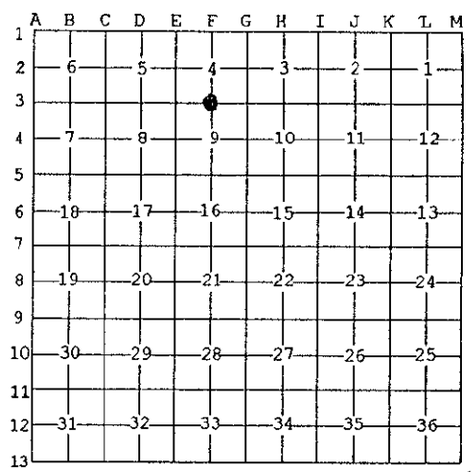

I, Kirk Breitels, in a field survey on May 25, 19 99 do hereby state that under requirements of P.A. 74, Michigan P.A. of 1970, the corner points mentioned in lines 1 and 2 above were in conformance with regulations and rules therefore as required in the current manual of survey instructions of the United States Department of the Interior, Bureau of Land Management or by a decree of a Court of Law and /or that the corner points mentioned in lines 3, 4 and 5 above were in conformance with the rules of the Michigan Board of Land Surveyors or by a Decree of a Court of Law; established, re-established, monumented, recovered, found as expressed below:

NOTE: Not more than 2 corners, all in the same town and range, may be recorded on this certificate.

P.A. 345 1990 KENT COUNTY
PEER APPROVED 6/24/99
CHAIRMAN [signature]

A. Description of original monument and accessories and/or subsequent restoration:

F-3	1837	GLO	Whitcomb	Set Post
	1964	Kent Co. Wits		1" Iron
	1981	LCRC #2045	E. Glaza	Iron
	1982	LCRC #3019	Starr	Set Kent County Monument
	1982	LCRC #3558	VanKooten	Kent County Monument
	1994	LCRC #7559	J. Glaza	Kent County Monument

The position of this corner was previously approved by the Kent County Remonumentation Peer Group, monumented by Thomas C. Starr on 8-2-82 and was recorded per LCRC #3019.

B. Description of corner evidence found and/or method applied in restoring or reestablishing corner:

F-3 Found Kent County Monument (Harrison) per witnesses from above LCRC as set by Thomas C. Starr in place of the ½" Iron Pipe over a 3/4" Iron Pipe he found. Both Iron Pipes check with Kent Co. Wits. and LCRC #2045.

LCRC #3019			LCRC #7559		
Nail & Remon. tag Tw. 30" Oak	S45°E	44.03'	Nail & Remon. tag 54" Twin Oak	S45°E	44.03'
Nail & Remon. tag 12" Oak	South	52.54'	Nail & Remon. tag 16" Oak	South	52.74'
Nail & Remon. tag P. Pole	S45°W	52.09'	Nail & Remon. tag P. Pole	S45°W	52.07'
Nail & Remon. tag 12" Poplar	N15°W	34.39'	Nail & Remon. tag 14" Poplar	N15°W	34.33'
Nail & Remon. tag 24" Oak	N50°E	66.22'	Nail & Remon. tag 30" Oak	N50°E	65.97'
Nail & Remon. tag 28" Oak	N75°E	88.25'	Nail & Remon. tag 32" Oak	N75°E	88.19'

The selected location is accepted by me and is generally accepted by professional surveyors as the best available evidence of the position of the original corner.

C. Description of monument for corner and accessories established to perpetuate locating the position of the corner:

F-3 Standard Kent County Monument

Nail & KC Remon. tag W. side 54" Twin Oak	S45°E	44.03'
Nail & KC Remon. tag W. side 20" Oak	South	52.72'
Nail & KC Remon. tag W. side P. Pole	S45°W	52.07'
Nail & KC Remon. tag W. side 18" Poplar	N15°W	34.30'
Nail & KC Remon. tag N. side 34" Oak	N75°E	88.19'

On C/L tree row South.
On C/L E-W asphalt road ±.

STATE OF MICHIGAN
KIRK BREITELS
LAND SURVEYOR
NO
30077
LICENSED LAND SURVEYOR

Signed by [signature] Date 6/24/99

Surveyor's Michigan License No. 30077

FORM APPROVED BY MICHIGAN STATE BOARD OF PROFESSIONAL SURVEYORS, JAN. 28, 1971
REVISED MAY 14,1975
REVISED JAN., 1983
REVISED OCT., 1995