

\$7.00
\$2.00

MAY 28 2000

KENT COUNTY REMONUMENTATION

SECTION

LAND CORNER RECORDATION CERTIFICATE
Filing Requirement of Act 74, Mich. P.A. 1970

STATE OF MICHIGAN
COUNTY OF KENT
RECEIVED FOR RECORD
1999 MAR 24 AM 8:02

REG. # 000000

11153

Register of Deeds Stamp & File Number


For corners in

KENT COUNTY (County)	Located In:	Corner Code #
	Tyrone Twp.	
1. Public Land Survey	T 10N R 12W	F-5
	T ___ R ___	___
	T ___ R ___	___
	T ___ R ___	___
2. Property Controlling in Section	S ___ T ___ R ___	___
	S ___ T ___ R ___	___
3. Miscellaneous Property in Sec.	S ___ T ___ R ___	___
	S ___ T ___ R ___	___

4. Lot No. _____, Recorded Plat _____
5. Private Claims _____

I, Kirk Breitels, in a field survey on Jan. 25, 19 99 do hereby state that under requirements of P.A. 74, Michigan P.A. of 1970, the corner points mentioned in lines 1 and 2 above were in conformance with regulations and rules therefore as required in the current manual of survey instructions of the United States Department of the Interior, Bureau of Land Management or by a decree of a Court of Law and /or that the corner points mentioned in lines 3, 4 and 5 above were in conformance with the rules of the Michigan Board of Land Surveyors or by a Decree of a Court of Law; established, re-established, monumented, recovered, found as expressed below:

NOTE: Not more than 2 corners, all in the same town and range, may be recorded on this certificate.

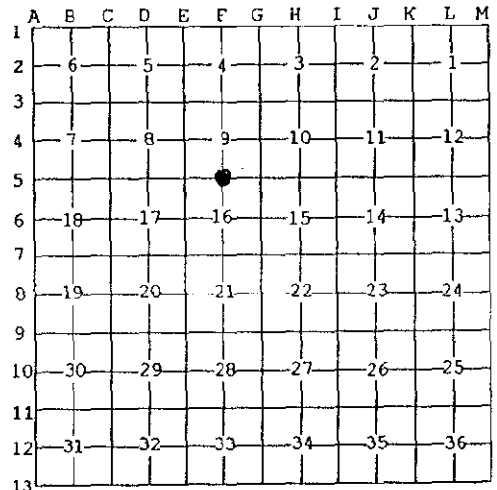

A. Description of original monument and accessories and/or subsequent restoration:

F-5 1837	GLO	Whitcomb	Set Post
1964	Kent Co. Wits		3/4" Iron
1981	LCRC #2080	Nederveld	Iron in Mon. Box
1982	LCRC #3027	Starr	Set Kent County Monument in Mon. Box
1994	LCRC #7551	J. Glaza	Kent County Monument

P.A. 345 1990 KENT COUNTY
PEER APPROVED 2/25/99
CHAIRMAN [Signature]

The position of this corner was previously approved by the Kent County Remonumentation Peer Group, monumented by Thomas C. Starr on 8-2-82 and was recorded per LCRC #3027.

B. Description of corner evidence found and/or method applied in restoring or reestablishing corner:

F-5 Found Kent County Monument (Harrison) per witnesses from above LCRC as set by Thomas C. Starr in place of the 3/4" Iron over a 1" Iron he found inside a Mon. Box. Both Irons check with LCRC#2080 and Kent Co. Wits.
LCRC #3027 LCRC #7551

Nail & Remon. tag 6" Maple	S05°W 50.17'	Nail & Remon. tag 9" Maple	S05°W 50.01'
Nail & Remon. tag 8" Ash	S30°E 57.24'	Nail & Remon. tag 10" Ash	S30°E 57.24'
Nail & Remon. tag Tw. 8" Maple	N55°E 77.34'	Nail & Remon. tag 10" Ash.,	N30°E 47.80'
Nail & Remon. tag 10" Ash	N30°E 47.81'	Nail & Remon. tag 16" Ash	North 55.61'
Nail & Remon. tag 16" Ash	North 55.56'	Nail & Remon. tag 6" Maple	N40°W 53.95'
Nail & Remon. tag 4" Maple	N40°W 53.92'	C/L of bit. road E-W & on tree row	South

The selected location is accepted by me and is generally accepted by professional surveyors as the best available evidence of the position of the original corner.

C. Description of monument for corner and accessories established to perpetuate locating the position of the corner:

F-5 Standard Kent County Monument in Mon. Box	
Nail & KC Remon. tag W. side 12" Maple	S05°W 50.01'
Nail & KC Remon. tag W. side 14" Ash	S30°E 57.21'
Nail & KC Remon. tag E. side 12" Ash	N30°E 47.82'
Nail & KC Remon. tag W. side 18" Oak	N00°E 55.61'
Nail & KC Remon. tag SW side 8" Maple	N40°W 53.95'
On C/L E-W bit. road	
On tree row South	



Signed by [Signature]
Surveyor's Michigan License No. 30077

Date 2/25/99