

KENT COUNTY REMONUMENTATION

LAND CORNER RECORDATION CERTIFICATE
 Filing Requirement of Act 74, Mich. P.A. 1970

STATE OF MICHIGAN
 COUNTY OF KENT
 RECEIVED
 93 OCT -6 AM 11:55

REG. OF DEEDS

For corners in

Kent
 (County)

Located In: **TYRONE TWP.**
 Corner Code **FF**

F-12
Center Sec. 33

- 1. Public Land Survey
- 2. Property Controlling in Section
- 3. Miscellaneous Property in Sec.
- 4. Lot No.
- 5. Private Claims

T	10N	R	12W
T	_____	R	_____
T	_____	R	_____
T	_____	R	_____
S	_____	T	_____
S	_____	T	_____
S	_____	T	_____
S	_____	T	_____

Recorded Plat _____

6851

Register of Deeds Stamp & File Number

	A	B	C	D	E	F	G	H	I	J	K	L	M
2	6	5	4	3	2	1							
3													
4	7	8	9	10	11	12							
5													
6	18	17	16	15	14	13							
7													
8	19	20	21	22	23	24							
9													
10	30	29	28	27	26	25							
11													
12	31	32	33	34	35	36							
13													

Thomas W. Chettleburgh

In a field survey on **May 7**, 1993
 do hereby certify that under requirements of P.A. 74, Michigan P.A. of 1970, the corner points mentioned in lines 1 and 2 above were in conformance with regulations and rules therefore as required in the current manual of survey instructions of the United States Department of the Interior, Bureau of Land Management or by a decree of a Court of Law and/or that the corner points mentioned in lines 3, 4 and 5 above were in conformance with the rules of the Michigan Board of Land Surveyors or by a Decree of a Court of Law, established, re-established, monumented, re-monumented, recovered, found as expressed below.

NOTE: Not more than 4 corners, all in the same town and range, may be recorded on this certificate.

A. Description of original monument and accessories and/or subsequent restoration.


- W&W 1910 Set stake & stone gauge R.R. 54.6'
- W&W 1952 Found stake, Centerline pay't SW 26.6, gauge R.R. 55.0, steel RR sign post ESE 93.8'
- W&W 1977 Record LCRC #1067
- Kent County Witness Map - same as W&W
- Nederveld & Jonker 1980 - held W&W center
- Exxel 1983 - held W&W center
- Chettleburgh 1987 - held W&W center

B. Description of corner evidence found and/or method applied in restoring or reestablishing corner.

- Found iron pipe from above witnesses 2.74' N & 0.03' W of intersection of 1/4 section lines
- Found Stone below iron pipe 2.4' deep (left in place)
- Found tee iron at intersection of 1/4 Section lines
- Hold iron pipe for center of Section - replace with Harrison Monument
- N 1/4 Section Corner N 0°17'15"W 2659.84'
- E 1/4 Section Corner N 89°52'53"W 2642.13'
- S 1/4 Section Corner S 0°17'20"E 2677.65'
- W 1/4 Section Corner N 90°00'00"W 2643.00'

C. Description of instrument for corner and accessories established to perpetuate locating the position of the corner.

- Set 4"X26" Standard Harrison Kent County Monument
- Southwesterly gage railroad N40°E 54.80'
- Nail/tag North side Power Pole N85°E 159.59'
- Nail/tag East side 32" Maple S10°E 125.28'
- Centerline Ball Creek Road S40°W 26.5'
- Nail/tag South Side Power Pole N78°W 219.57'
- Nail/tag NE side Power Pole N25°W 24.15'

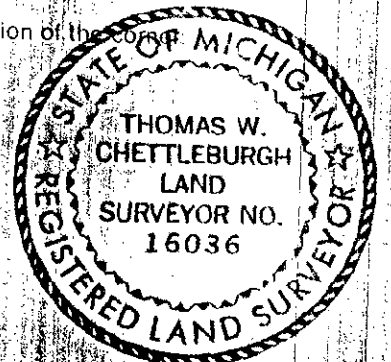

Signed by

Thomas W. Chettleburgh

Date **September 20, 1993**

Surveyor's Michigan License No.

16036