

\$7.00
\$2.00

MAY 22 2000

KENT COUNTY REMONUMENTATION

SECTION

LAND CORNER RECORDATION CERTIFICATE Filing Requirement of Act 74, Mich. P.A. 1970

For corners in

KENT COUNTY

(County)

Located In:

Corner Code #

1. Public Land Survey

T 10N R 12W

Tyrone Twp.
G-3

2. Property Controlling in Section

S _____ T _____ R _____
S _____ T _____ R _____

3. Miscellaneous Property in Sec.

S _____ T _____ R _____
S _____ T _____ R _____

4. Lot No. _____, Recorded Plat _____
5. Private Claims _____

STATE OF MICHIGAN
COUNTY OF KENT
RECEIVED FOR RECORD

1999 MAR 24 AM 8:02


REG. OF DEEDS

[Signature]

11159
Register of Deeds Stamp & File Number

I, Kirk Breitels, in a field survey on Feb. 9, 19 99 do hereby state that under requirements of P.A. 74, Michigan P.A. of 1970, the corner points mentioned in lines 1 and 2 above were in conformance with regulations and rules therefore as required in the current manual of survey instructions of the United States Department of the Interior, Bureau of Land Management or by a decree of a Court of Law and /or that the corner points mentioned in lines 3, 4 and 5 above were in conformance with the rules of the Michigan Board of Land Surveyors or by a Decree of a Court of Law; established, re-established, monumented, recovered, found as expressed below:

NOTE: Not more than 2 corners, all in the same town and range, may be recorded on this certificate.

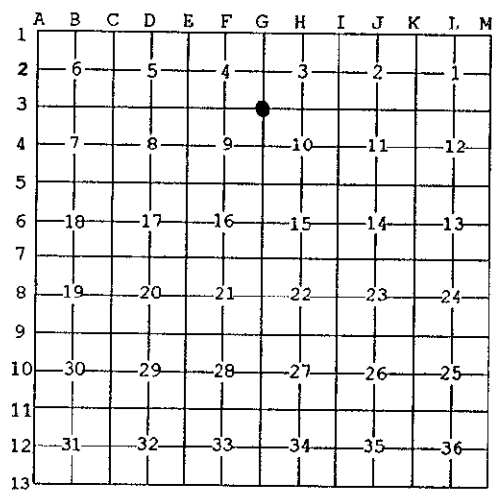

A. Description of original monument and accessories and/or subsequent restoration:

G-3 1837	GLO	Whitcomb	Set Post
1966	Kent Co. Wits		3/4" Pipe
1975	LCRC #825	Bonnema	3/4" Iron
1983	LCRC #3440	Bueche	Set Kent County Monument
1994	LCRC #7558	J. Glaza	Kent County Monument

P.A. 345 1990 KENT COUNTY
PEER APPROVED 2/25/99
CHAIRMAN [Signature]

The position of this corner was previously approved by the Kent County Remonumentation Peer Group, monumented by John C. Bueche on 5-24-83 and was recorded per LCRC #3440.

B. Description of corner evidence found and/or method applied in restoring or reestablishing corner:

G-3 Found Kent County Monument (Harrison) per witnesses from above LCRC as set by John C. Bueche in place of the 3/4" Iron over a Rerod and Pointed Stone he found. All check with Kent Co. Wits. and LCRC #825.

LCRC #3440	NE cor. garage blk. fnd.	S45°W 146.58'	NE corner garage blk. fnd.	S45°W 146.44'
	SW corner house foundation	N55°E 110.10'	SW corner house foundation	N55°E 109.70'
	NE corner house foundation	N55°W 207.22'	NE corner house foundation	N55°W 207.24'
	Nail & Remon. tag P. Pole	S75°E 130.34'	Nail & Remon. tag P. Pole	S75°E 130.32'
	"V" cut NW leg of tower	N15°E 237.88'	"V" cut SW leg of tower	N15°E 237.77'
	"V" cut NE leg of tower	S20°E 162.33'	"V" cut NE leg of tower	S20°E 162.28'

The selected location is accepted by me and is generally accepted by professional surveyors as the best available evidence of the position of the original corner.

C. Description of monument for corner and accessories established to perpetuate locating the position of the corner:

G-3 Standard Kent County Monument

NE corner garage block foundation	S45°W 146.54'
SW corner house siding	N55°E 109.70'
NE corner house foundation	N55°W 207.18'
Nail & KC Remon. tag S. side P. Pole	S75°E 130.36'
"V" cut (3' high) on SW leg of tower	N15°E 237.77'
"V" cut (3' high) on NE leg of tower	S20°E 162.33'
C/L blacktop road N-S is 2.5' East ±	
On C/L blacktop road West and gravel road East ±	



Signed by [Signature]
Surveyor's Michigan License No. 30077

Date 2/25/99