

\$7.00
\$2.00

MAY 22 2000

KENT COUNTY REMONUMENTATION

SECTION

LAND CORNER RECORDATION CERTIFICATE Filing Requirement of Act 74, Mich. P.A. 1970

For corners in
KENT COUNTY
(County)

Located In:	Corner Code #
	Tyrone Twp.
1. Public Land Survey	T <u>10</u> N R <u>12</u> W G-5
	T _____ R _____
	T _____ R _____
	T _____ R _____
2. Property Controlling in Section	S _____ T _____ R _____
	S _____ T _____ R _____
3. Miscellaneous Property in Sec.	S _____ T _____ R _____
	S _____ T _____ R _____

STATE OF MICHIGAN
COUNTY OF KENT
RECEIVED FOR RECORD

1999 MAR 24 AM 8:02

REG. OF DEEDS

11161

Register of Deeds Stamp & File Number

4. Lot No. _____, Recorded Plat _____
5. Private Claims _____

I, Kirk Breitels, in a field survey on Feb. 9, 1999 do hereby state that under requirements of P.A. 74, Michigan P.A. of 1970, the corner points mentioned in lines 1 and 2 above were in conformance with regulations and rules therefore as required in the current manual of survey instructions of the United States Department of the Interior, Bureau of Land Management or by a decree of a Court of Law and /or that the corner points mentioned in lines 3, 4 and 5 above were in conformance with the rules of the Michigan Board of Land Surveyors or by a Decree of a Court of Law; established, re-established, monumented, recovered, found as expressed below:

NOTE: Not more than 2 corners, all in the same town and range, may be recorded on this certificate.

A	B	C	D	E	F	G	H	I	J	K	L	M
1												
2	6	5	4	3	2	1						
3												
4	7	8	9	10	11	12						
5												
6	18	17	16	15	14	13						
7												
8	19	20	21	22	23	24						
9												
10	30	29	28	27	26	25						
11												
12	31	32	33	34	35	36						
13												

A. Description of original monument and accessories and/or subsequent restoration:

G-5 1837	GLO	Whitcomb	Set Post
1964	Kent Co. Wits		Mon. Box
1975	LCRC #825	Bonnema	3/4" Iron in Mon. Box
1983	LCRC #3427	Bueche	Set Kent County Monument in Mon. Box
1994	LCRC #7543	J. Glaza	Kent County Monument

P.A. 345 1900 KENT COUNTY
PEER APPROVED 2/25/99
CHAIRMAN Harry Huber

The position of this corner was previously approved by the Kent County Remonumentation Peer Group, monumented by John C. Bueche on 5-18-83 and was recorded per LCRC #3427.


B. Description of corner evidence found and/or method applied in restoring or reestablishing corner:

G-5 Found Kent County Monument (Harrison) per witnesses from above LCRC as set by John C. Bueche in place of the Iron he found in a Mon. Box over a Conc. Mon. Said Iron and Conc. Mo. checks with Kent Co. Wits. and LCRC #825.	
LCRC #3427	LCRC #7543
SE cor. house foundation N40°W 137.28'	SE corner house foundation N40°W 137.32'
PK Nail top guard post N85°E 144.03'	PK Nail top of W'yly guard post N85°E 144.03'
"X" cut in curb return N35°W 37.15'	"X" cut in curb return N35°W 37.15'
"X" cut in curb return N45°E 36.27'	"X" cut in curb return N45°E 36.29'
"X" cut in curb return S35°W 37.33'	"X" cut in curb return S35°W 37.33'
"X" cut in curb return S50°E 36.32'	"X" cut in curb return S50°E 36.32'

The selected location is accepted by me and is generally accepted by professional surveyors as the best available evidence of the position of the original corner.

C. Description of monument for corner and accessories established to perpetuate locating the position of the corner:

G-5 Standard Kent County Monument in Mon. Box
SE corner house foundation N40°W 137.32'
PK Nail top W. guard post N85°E 144.00'
"X" cut top of concrete curb N35°W 37.17'
"X" cut top of concrete curb N45°E 36.29'
"X" cut top of concrete curb S35°W 37.33'
"X" cut top of concrete curb S50°E 36.36'
On C/L blacktop N-S & E-W

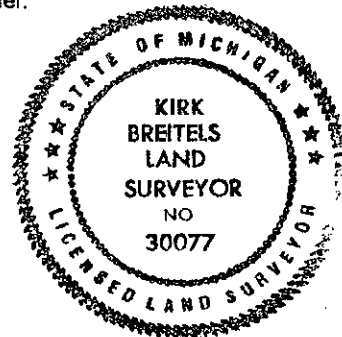

Signed by Kirk Breitels
Surveyor's Michigan License No. 30077

Date 2/25/99