

KENT COUNTY REMONUMENTATION

LAND CORNER RECORDATION CERTIFICATE  
Filing Requirement of Act 74, Mich. P.A. 1970

\$7.00  
\$2.00

MAY 22 2000

SECTION

STATE OF MICHIGAN  
COUNTY OF KENT  
RECEIVED FOR RECORD  
1999 MAR 24 AM 8:02

For corners in

KENT COUNTY (County)	Located In:	Corner Code #
		Tyrone Twp.
		H-11
1. Public Land Survey	T 10NR 12W	
	T ___ R ___	
	T ___ R ___	
	T ___ R ___	
2. Property Controlling in Section	S ___ T ___ R ___	
	S ___ T ___ R ___	
3. Miscellaneous Property in Sec.	S ___ T ___ R ___	
	S ___ T ___ R ___	

REQ. OF SEEDS


11171

Register of Deeds Stamp & File Number

4. Lot No. \_\_\_\_\_, Recorded Plat \_\_\_\_\_  
5. Private Claims \_\_\_\_\_

I, Kirk Breitels, in a field survey on Feb. 18, 19 99 do hereby state that under requirements of P.A. 74, Michigan P.A. of 1970, the corner points mentioned in lines 1 and 2 above were in conformance with regulations and rules therefore as required in the current manual of survey instructions of the United States Department of the Interior, Bureau of Land Management or by a decree of a Court of Law and/or that the corner points mentioned in lines 3, 4 and 5 above were in conformance with the rules of the Michigan Board of Land Surveyors or by a Decree of a Court of Law; established, re-established, monumented, recovered, found as expressed below:

NOTE: Not more than 2 corners, all in the same town and range, may be recorded on this certificate.

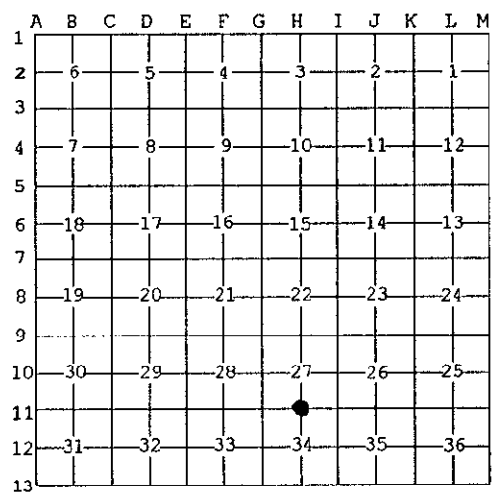

A. Description of original monument and accessories and/or subsequent restoration:

H-11 1837	GLO	Whitcomb	Set Post
	Kent Co. Wits		Stone & Iron
1974	LCRC #701	Spicer	3/4" Iron
1982	LCRC #3007	Starr	Set Kent County Monument in Mon. Box
1991	LCRC #6000	Byl	Kent County Monument in Mon. Box

P.A. 345 1990 KENT COUNTY  
PEER APPROVED 2/25/99  
CHAIRMAN *Henry Huber*

The position of this corner was previously approved by the Kent County Remonumentation Peer Group, monumented by Thomas C. Starr on 8-2-82 and was recorded per LCRC #3007.

B. Description of corner evidence found and/or method applied in restoring or reestablishing corner:

H-11 Found Kent County Monument (Harrison) per witnesses from above LCRC as set by Thomas C. Starr in place of the 1" Rebar he found in a Mon. Box. Said Rebar checks with Kent Co. Wits. and LCRC #701.

LCRC #3007	LCRC #6000
Nail & Remon. tag P. Pole S70°E 115.32'	Nail & Remon. tag P. Pole S70°E 115.32'
Nail & Remon. tag P. Pole N45°E 165.21'	Nail & Remon. tag P. Pole N45°E 165.15'
Nail & Remon. tag P. Pole N15°E 124.20'	Nail & Remon. tag P. Pole N15°E 124.10'
C/L top Tel. Undgrd. Box N65°E 98.05'	Top C/L Tel. Undgrd. Box N65°E 97.90'
C/L 2" Maple N60°W 96.35'	C/L 3" Maple N60°W 96.35'
C/L 1" Maple N30°W 70.60'	C/L 2" Maple N45°W 82.0'

The selected location is accepted by me and is generally accepted by professional surveyors as the best available evidence of the position of the original corner.

C. Description of monument for corner and accessories established to perpetuate locating the position of the corner:

H-11 Standard Kent County Monument in Mon. Box	
Nail & KC Remon. tag NW side newer P. Pole	N45°E 162.87'
Nail & KC Remon. tag W. side P. Pole	N15°E 124.07'
C/L top Tel. Underground Box	N65°E 97.80'
Nail & KC Remon. tag S. side 6" Maple	N74°W 96.24'
Nail & KC Remon. tag W. side P. Pole	S02°E 228.40'
On C/L E-W asphalt road ±	
50' ± West of C/L asphalt road to North	



Signed by *Kirk Breitels*  
Surveyor's Michigan License No. 30077

Date 2/25/99