

MAY 22 2000

\$7.00
\$2.00

SECTION

KENT COUNTY REMONUMENTATION

LAND CORNER RECORDATION CERTIFICATE
Filing Requirement of Act 74, Mich. P.A. 1970

For corners in

KENT COUNTY
(County)

Located In:

Corner Code #

1. Public Land Survey

T10N R 12W

Tyrone Twp.
I-3

2. Property Controlling
in Section

S T R

3. Miscellaneous
Property in Sec.

S T R

REG. OF DEEDS

STATE OF MICHIGAN
COUNTY OF KENT
RECEIVED FOR RECORD
1999 JUL -9 AM 11:20


11257

Register of Deeds Stamp & File Number

4. Lot No. _____, Recorded Plat _____
5. Private Claims _____

I, Kirk Breitels, in a field survey on May 26, 19 99 do hereby state that under requirements of P.A. 74, Michigan P.A. of 1970, the corner points mentioned in lines 1 and 2 above were in conformance with regulations and rules therefore as required in the current manual of survey instructions of the United States Department of the Interior, Bureau of Land Management or by a decree of a Court of Law and/or that the corner points mentioned in lines 3, 4 and 5 above were in conformance with the rules of the Michigan Board of Land Surveyors or by a Decree of a Court of Law; established, re-established, monumented, recovered, found as expressed below:

NOTE: Not more than 2 corners, all in the same town and range, may be recorded on this certificate.

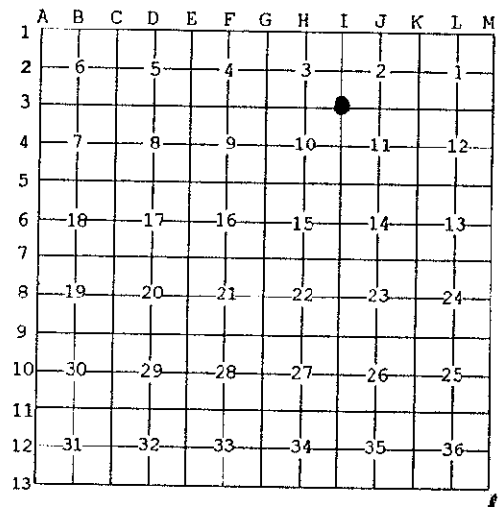

A. Description of original monument and accessories and/or subsequent restoration:

I-3	1837	GLO	Whitcomb	Set Post
	1975	LCRC #824	Bonnema	Set 1/2" Iron over Stone
	1982	LCRC #3005	Starr	Set Kent County Monument
	1991	LCRC #5778	Bueche	Reset Kent County Monument
	1991	LCRC #6004	Byl	Kent County Monument

P.A. 345 1990 KENT COUNTY
PEER APPROVED 6/24/99
CHAIRMAN Harry Kubacki

The position of this corner was previously approved by the Kent County Remonumentation Peer Group, monumented by Thomas C. Starr on 8-2-82 and was recorded per LCRC #3005.

B. Description of corner evidence found and/or method applied in restoring or reestablishing corner:

I-3 Found BROKEN Kent County Monument (Harrison) per witnesses from above LCRC as set by Thomas C. Starr in place of the 1/2" Iron Pipe he found. Said Iron Pipe checks with LCRC #824.
LCRC #3005 & #5778 LCRC #6004

Nail & Remon. tag 10" Poplar S65°E 95.35'	Nail & Remon. tag 12" Poplar S60°E 95.30'
Nail & Remon. tag 6" Poplar S20°E 61.87'	Nail & Remon. tag 8" Poplar S20°W 61.87'
Nail & Remon. tag P. Pole N20°W 74.68'	Nail & Remon. tag P. Pole N20°W 74.70'
Nail & Remon. tag 16" Maple N10°E 109.56'	Nail & Remon. tag 18" Maple N10°E 109.60'
NE corner block garage S65°W 84.33'	NE corner block garage S65°W 84.31'
SW corner frame house N55°E 104.02'	SW corner frame house N55°E 109.98'
	NW corner conc. post S35°E 34.80'

The selected location is accepted by me and is generally accepted by professional surveyors as the best available evidence of the position of the original corner.

C. Description of monument for corner and accessories established to perpetuate locating the position of the corner:

I-3 Removed and Replaced Standard Kent County Monument

Nail & KC Remon. tag N. side 14" Poplar	S60°E 95.30'
Nail & KC Remon. tag W. side P. Pole	N20°W 74.73'
Nail & KC Remon. tag W. side 20" Maple	N10°E 109.60'
NE corner concrete block garage	S65°W 84.36'
SW corner frame house	N55°E 103.98'
NW corner concrete post	S35°E 34.84'

At C/L gravel roads N-S-W ±



Signed by [Signature]
Surveyor's Michigan License No. 30077

Date 6/24/99